

JACKSON
 Q 269
 10-64

MISSISSIPPI
 BOARD OF WATER COMMISSIONERS
 416 North State Street
 Jackson, Mississippi 39201

WATER WELL DRILLERS LOG

Oct 1 1964 Colville Water Supply Jackson
 date well completed firm name county well located

LANDOWNER: J B Macklin
Dautier Miss
 (mailing address)
 WELL LOCATION:
~~Q 269~~ T 7 N R 7 E
5 1/2 miles Kat of Perre
 (distance) (direction) (nearest town)

description of formations encountered	from	to
<u>yellow clay</u>	<u>0</u>	<u>10</u>
<u>soft blue clay</u>	<u>10</u>	<u>44</u>
<u>sand</u>	<u>44</u>	<u>104</u>
<u>clay</u>	<u>104</u>	<u>198</u>
<u>sand</u>	<u>198</u>	<u>300</u>
<u>clay</u>	<u>300</u>	<u>357</u>
<u>sand</u>	<u>357</u>	<u>385</u>

WELL PURPOSE: home
 (home, irrigation, municipal, industrial)

WELL COMPLETION DATA:
 (1) diameter (inches) 2
 (2) total depth (feet) 385
 (3) static water level (feet) 5 below above
 top of ground.
 (4) casing Polo, 380,
 (material) (depth)
 (size) If telescope see back.
 (5) screen 5, 380
 (length) (depth to top)
1', stainless
 (size) (material)
 (6) pump _____
 (HP) (yield gpm)
 (type power)
 (7) electric log no
 (yes or no)
 (organization running log)
 (8) how well bottom plugged B.P. Valve


MAY 27 1968

MISS. BOARD OF
 WATER COMMISSIONERS

DRILLERS REMARKS: Pump installed by owner

If well telescopes please sketch and show depths.

GROUND LEVEL

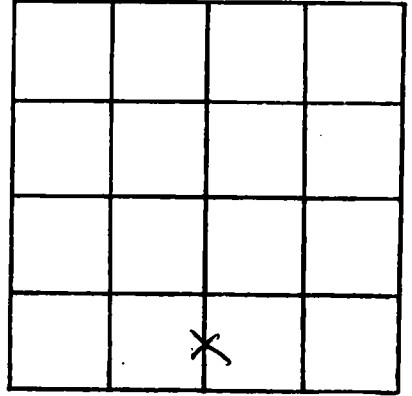

SECTION 8

Please indicate well location X.

ADDITIONAL INFORMATION

If more than one screen, show locations of each on sketch.