

JACKSON  
Q 270  
4-64

MISSISSIPPI  
BOARD OF WATER COMMISSIONERS  
416 North State Street  
Jackson, Mississippi 39201

WATER WELL DRILLERS LOG

April 15 1964 Calwell Water Supply Jackson  
date well completed firm name county well located

LANDOWNER: J. P. Lowe

description of formations encountered	from to	
	ft	ft
Clay sand	0	86
	86	101

Bayou LaSalle Miss.  
(mailing address)

WELL LOCATION: NW 1/4  
sec 17 T 8 N R 5 E  
3 miles SW of Pascagoula  
(distance) (direction) (nearest town)

WELL PURPOSE: Home  
(home, irrigation, municipal, industrial)

WELL COMPLETION DATA:

(1) diameter (inches) 1 1/4  
(2) total depth (feet) 101  
(3) static water level (feet) 15 below above top of ground  
(4) casing galv. (material), (depth)  
(size) If telescope see back.  
(5) screen 5 96  
(length) (depth to top)  
1/4" plastic  
(size) (material)

(6) pump (HP) (yield gpm)  
(type power)

(7) electric log no  
(yes or no)

(organization running log)


(8) how well bottom plugged BP Valve

MAY 27 1968  
MISS. BOARD OF WATER

DRILLERS REMARKS:

If well telescopes please sketch and show depths.

**GROUND LEVEL**

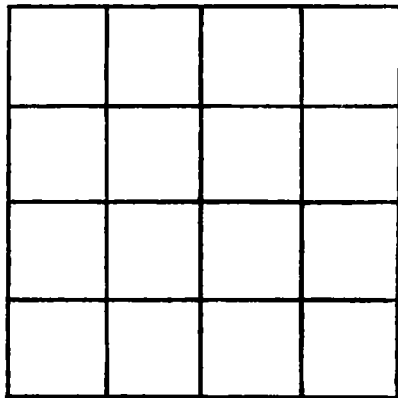

**SECTION \_\_\_\_\_**

**Please indicate well location X.**

**ADDITIONAL INFORMATION**

If more than one screen,  
show locations of each on sketch.