

CODED

Jackson
Q 273
7-7-65

MISSISSIPPI
BOARD OF WATER COMMISSIONERS
416 North State Street
Jackson, Mississippi 39201

WATER WELL DRILLERS LOG

July 7 1965 White Water Supply Jackson
date well completed firm name county well located


LANDOWNER: Robert E.
M^{rs} Concepcion
Tombish Creek
(mailing address)

description of formations encountered	from	to
clay with streaks of sand	0	66
red clay	66	330
sand	330	428

WELL LOCATION:
sec. 31 T. 7 N. R. 5 E
5 miles NE of MP
(distance) (direction) (nearest town)

WELL PURPOSE: home
(home, irrigation, municipal, industrial)

- WELL COMPLETION DATA:
- (1) diameter (inches) 2
 - (2) total depth (feet) 428
 - (3) static water level (feet) 2 below top of ground.
 - (4) casing Galv (material), (depth) (size) If telescope see back.
 - (5) screen 5 (length), 423 (depth to top)
2 (size), stumbers (material)
 - (6) pump no pump (HP) (yield gpm)
(type power)
 - (7) electric log no (yes or no)
(organization running log)
 - (8) how well bottom plugged B.P. Valoy

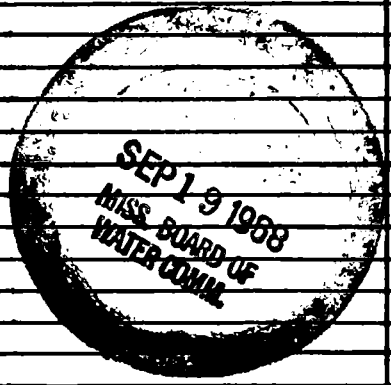

DRILLERS REMARKS:

if well telescopes please
sketch and show depths.

GROUND LEVEL

			X
		"	

SECTION 31

Please indicate well location X.

ADDITIONAL INFORMATION

If more than one screen,
show locations of each on sketch.