

Jackson
 Q 27A
 10-20-65

MISSISSIPPI
 BOARD OF WATER COMMISSIONERS
 416 North State Street
 Jackson, Mississippi 39201

CODED

WATER WELL DRILLERS LOG

Oct 20 19 65 Charlie Water Supply Jackson
 date well completed firm name county well located

LANDOWNER: W. B. Stockman
Rayson
 (mailing address)

| description of formations encountered | from | to |
|---------------------------------------|------|-----|
| sand | 7 | 74 |
| clay | 74 | 104 |
| sand | 104 | 148 |
| clay | 148 | 194 |
| sand | 194 | 253 |

WELL LOCATION:
 sec. 26 T 7 N R 5 E
4 miles East of MP
 (distance) (direction) (nearest town)

WELL PURPOSE: home
 (home, irrigation, municipal, industrial)

WELL COMPLETION DATA:
 (1) diameter (inches) 2 x 1 1/4
 (2) total depth (feet) 253
 (3) static water level (feet) 28 ^{below} top of ground. 137 2" ^{above}
 (4) casing galv 175' 1/4
 (material) (depth)

_____ If telescope see back.
 (size)
 (5) screen 5 248
 (length) (depth to top)
1 1/4 stainless
 (size) (material)


(6) pump _____ (HP) _____ (yield gpm)
 (type power)

(7) electric log no
 (yes or no)

(organization running log)


(8) how well bottom plugged B.P. valve

DRILLERS REMARKS: pump installed by owner

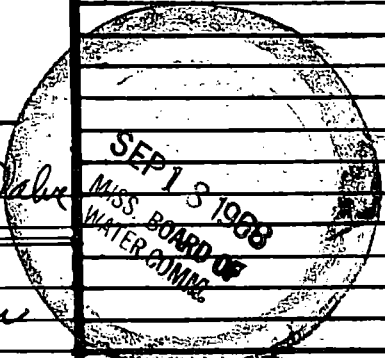

If well telescopes please sketch and show depths.

GROUND LEVEL

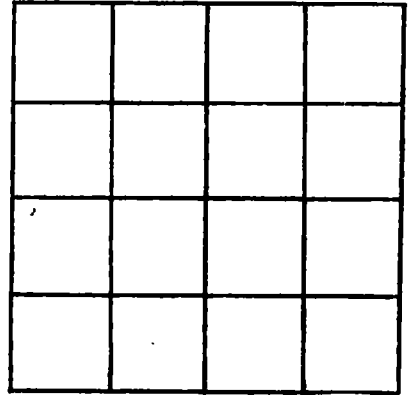

SECTION 26

Please indicate well location X.

ADDITIONAL INFORMATION

If more than one screen, show locations of each on sketch.