

**MISSISSIPPI
BOARD OF WATER COMMISSIONERS
416 North State Street
Jackson, Mississippi 39201**

CODED

WATER WELL DRILLERS LOG

Jackson
Q 215
9-7-65

Sept 7 1965 Corbett Water Supply Jackson
date well completed firm name county well located

LANDOWNER: Robert O' Sullivan
Bayou LaSalle, Miss
(mailing address)

description of formations encountered	from	to
<u>Clay</u>	<u>0</u>	<u>118</u>
<u>sand</u>	<u>118</u>	<u>218</u>
<u>Clay</u>	<u>218</u>	<u>286</u>
<u>sand</u>	<u>286</u>	<u>327</u>

WELL LOCATION:
sec. 8 T. 8 N. R. 5 E.
2 miles SE of Pine
(distance) (direction) (nearest town)

WELL PURPOSE: Home
(home, irrigation, municipal, industrial)

WELL COMPLETION DATA:
(1) diameter (inches) 2 X 1 1/4
(2) total depth (feet) 327
(3) static water level (feet) 94 ^{below} 126 ^{above} top of ground
(4) casing galv 189 1 1/4 in
(material) (depth)

_____ if telescope see back.
(size)
(5) screen 5 322
(length) (depth to top)
1 1/4 Copper gauze
(size) (material)


(6) pump 1 5
(HP) (yield gpm)
elec
(type power)

(7) electric log no
(yes or no)

(organization running log)


(8) how well bottom plugged BP Valve

DRILLERS REMARKS:

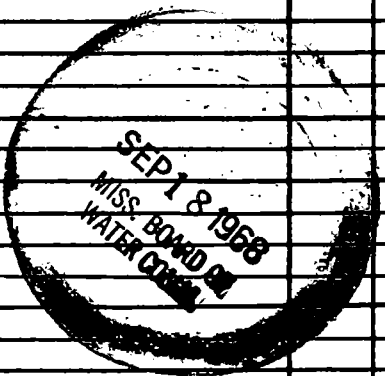

If well telescopes please sketch and show depths.

GROUND LEVEL

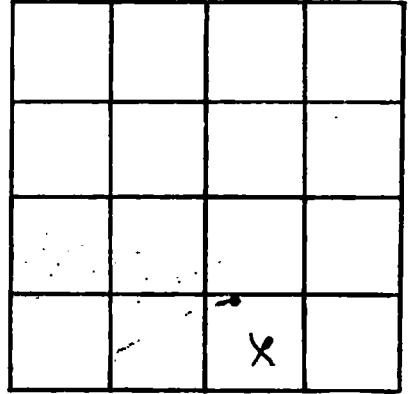

SECTION 8

Please indicate well location X.

ADDITIONAL INFORMATION

If more than one screen, show locations of each on sketch.