

Jackson
 Q 276
 10-25-64

MISSISSIPPI
 BOARD OF WATER COMMISSIONERS
 416 North State Street
 Jackson, Mississippi 39201

CODED

WATER WELL DRILLERS LOG

Oct 25 1964 Colwell Water Supply Jackson
 date well completed firm name county well located

LANDOWNER: Sam
Presley
Orange Grove - Miss.
 (mailing address)

description of formations encountered	from	to
	Clay	0
sand	10	44
Clay	44	94
sand	94	224
Clay	224	335
sand	335	426

WELL LOCATION:
 sec. 5 T. 7 N. R. 5 E
13 miles East of MP
 (distance) (direction) (nearest town)

WELL PURPOSE: Drainage
 (home, irrigation, municipal, industrial)

WELL COMPLETION DATA:

(1) diameter (inches) 2"

(2) total depth (feet) 426

(3) static water level (feet) 22 below above top of ground.

(4) casing _____ (material) _____ (depth) _____ (size) If telescope see back.

(5) screen 5 _____ 421 _____
 (length) (depth to top)
2 _____ stainless _____
 (size) (material)


(6) pump no pump _____
 (HP) (yield gpm)

_____ (type power)

(7) electric log no _____
 (yes or no)

_____ (organization running log)

(8) how well bottom plugged DP 1/2 in

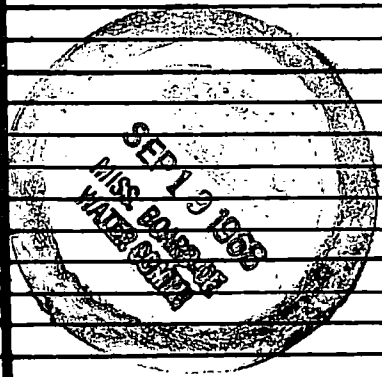

DRILLERS REMARKS: _____

If well telescopes please sketch and show depths.

GROUND LEVEL

			X

SECTION 5

Please indicate well location X.

ADDITIONAL INFORMATION

If more than one screen, show locations of each on sketch.