

CODED

Jackson  
Q 277  
12-9-64

MISSISSIPPI  
BOARD OF WATER COMMISSIONERS  
416 North State Street  
Jackson, Mississippi 39201

WATER WELL DRILLERS LOG

Dec 9 1964 Colville Water Supply Jackson  
date well completed firm name county well located

LANDOWNER: Horace Culpepper  
Orange Grove Miss  
(mailing address)


description of formations encountered	from	to
<u>clay</u>	<u>0</u>	<u>22</u>
<u>mud</u>	<u>22</u>	<u>99</u>

WELL LOCATION:  
sec. 13 T. 7 N. R. 5 E.  
2 1/4 miles NE of MDP  
(distance) (direction) (nearest town)

WELL PURPOSE: home  
(home, irrigation, municipal, industrial)

WELL COMPLETION DATA:


- (1) diameter (inches) 1 1/4
- (2) total depth (feet) 99
- (3) static water level (feet) 5 <sup>below</sup> above top of ground.
- (4) casing galv  
(material) (depth)
- \_\_\_\_\_ if telescope see back.  
(size)
- (5) screen 4 95  
(length) (depth to top)
- 1 1/4 copper  
(size) (material)
- (6) pump \_\_\_\_\_ (HP) \_\_\_\_\_ (yield gpm)
- (type power)
- (7) electric log no  
(yes or no)
- (organization running log)
- (8) how well bottom plugged BPA

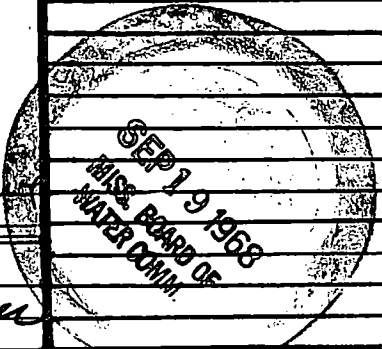

DRILLERS REMARKS: Pump installed by owner

If well telescopes please sketch and show depths.

GROUND LEVEL

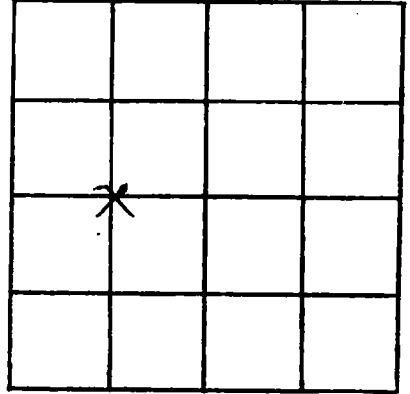

SECTION 13

Please indicate well location X.

ADDITIONAL INFORMATION

If more than one screen,  
show locations of each on sketch.