

CODED

MISSISSIPPI
BOARD OF WATER COMMISSIONERS
416 North State Street
Jackson, Mississippi 39201


WATER WELL DRILLERS LOG

Jackson
Q218
12-21-64

Dec 21 1964 Little White Supply Jackson
date well completed firm name county well located


LANDOWNER:	description of formations encountered	from	to
<u>John L. Ray</u>	<u>soft blue clay & silt</u>	<u>0</u>	<u>114</u>
<u>Pearl Miss</u> (mailing address)	<u>fine sand</u>	<u>114</u>	<u>127</u>
	<u>clay</u>	<u>122</u>	<u>166</u>
	<u>sand</u>	<u>166</u>	<u>199</u>
WELL LOCATION: sec <u>8</u> T <u>9</u> N R <u>5</u> E <u>10</u> miles <u>east</u> of <u>Memphis</u> (distance) (direction) (nearest town)			
WELL PURPOSE: <u>home</u> (home, irrigation, municipal, industrial)			
WELL COMPLETION DATA:			
(1) diameter (inches) <u>1 1/4</u>			
(2) total depth (feet) <u>199</u>			
(3) static water level (feet) <u>3</u> <u>below</u> top of ground.			
(4) casing <u>galv</u> (material) (depth)			
<u>1 1/4</u> If telescope see back. (size)			
(5) screen <u>5</u> <u>194</u> (length) (depth to top)			
<u>1 1/4</u> <u>cap</u> (size) (material)			
(6) pump _____ (HP) (yield gpm)			
(type power)			
(7) electric log <u>no</u> (yes or no)			
(organization running log)			
(8) how well bottom plugged <u>BP galv</u>			
DRILLERS REMARKS: <u>pumps installed by owner</u>			

CODED

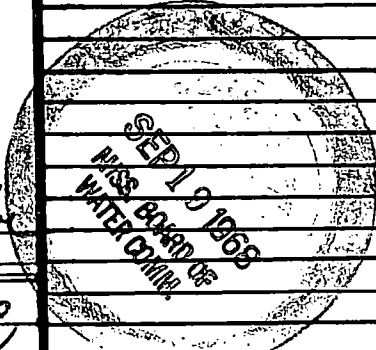

If well telescopes please sketch and show depths.

GROUND LEVEL

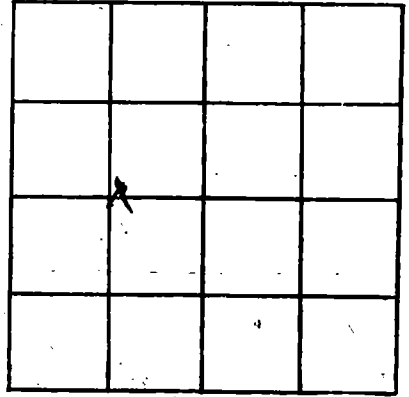

SECTION 18

Please indicate well location X.

ADDITIONAL INFORMATION

If more than one screen,
show locations of each on sketch.