

Jackson
 Q2A
 1-21-65

MISSISSIPPI
 BOARD OF WATER COMMISSIONERS
 416 North State Street
 Jackson, Mississippi 39201

CODED

WATER WELL DRILLERS LOG

Jan 21 1965 date well completed
 65 Colville Water Supply firm name
 Jackson county well located

LANDOWNER: Larry
 Nicholson
 Orange Grove Mtn
 (mailing address)

description of formations encountered	from	to
stuck	0	22
clay	22	60
gravel	60	132
clay	132	184
sand	184	256

WELL LOCATION:
 sec. 22 T. 7 N. R. 5 E
 2 miles East of Mt. Point
 (distance) (direction) (nearest town)

WELL PURPOSE: home
 (home, irrigation, municipal, industrial)

WELL COMPLETION DATA:

(1) diameter (inches) 2x1 1/4

(2) total depth (feet) 256

(3) static water level (feet) 28 below top of ground

(4) casing (material) Galv (depth) 3"

_____ if telescope see back. (size)

(5) screen (length) 5' (depth to top) 251

(size) 1 1/4" (material) Lopper Gramp


(6) pump (HP) _____ (yield gpm) _____

(type power) _____

(7) electric log no (yes or no)

(organization running log) _____


(8) how well bottom plugged B.P. Value

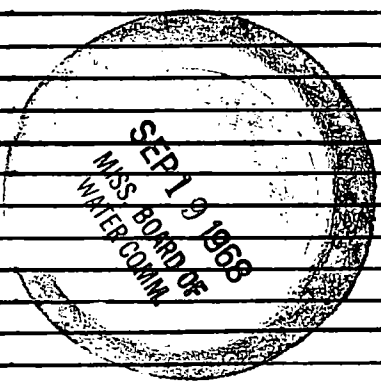

DRILLERS REMARKS:

If well telescopes please sketch and show depths.

GROUND LEVEL

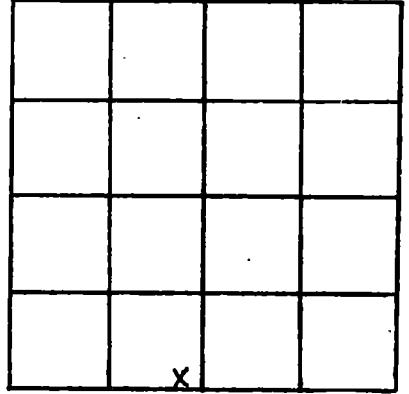

SECTION 22

Please indicate well location X.

ADDITIONAL INFORMATION

If more than one screen, show locations of each on sketch.