

INDEXED

Jackson
Q 280
6-24-65

MISSISSIPPI
BOARD OF WATER COMMISSIONERS
416 North State Street
Jackson, Mississippi 39201

WATER WELL DRILLERS LOG

June 24 1965
date well completed

Capville Water Sup
firm name

Jackson
county well located

LANDOWNER: Joyce

description of formations encountered

from to

Powell

<u>Clay</u>	<u>7</u>	<u>44</u>
<u>Sand</u>	<u>44</u>	<u>150</u>
<u>Clay</u>	<u>150</u>	<u>210</u>
<u>Sand</u>	<u>210</u>	<u>262</u>

Rayon Lambert
(mailing address)

WELL LOCATION:

sec. 27 T-7 N R-5 E
4 miles SE of MP
(distance) (direction) (nearest town)

WELL PURPOSE: Home
(home, irrigation, municipal, industrial)

WELL COMPLETION DATA:

- (1) diameter (inches) 2"
- (2) total depth (feet) 262
- (3) static water level (feet) 28 ^{below} top of ground. 84' 2" above
- (4) casing galv rust 1 1/4
(material) (depth)

(size) if telescope see back.

- (5) screen 10 252
(length) (depth to top)
- 1 1/4 Copper gauze
(size) (material)


- (6) pump _____ (HP) _____ (yield gpm)
- (type power) _____

- (7) electric log no
(yes or no)

(organization running log)


- (8) how well bottom plugged B.P. Valve

DRILLERS REMARKS: pump installed by owner

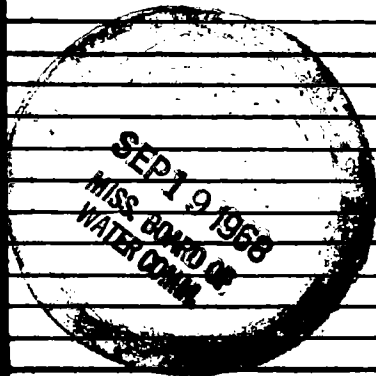

If well telescopes please sketch and show depths.

GROUND LEVEL

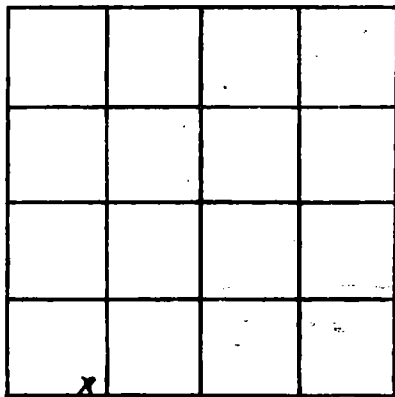

SECTION 27

Please indicate well location X.

ADDITIONAL INFORMATION

If more than one screen, show locations of each on sketch.