

CODED

Jackson
Q 281
5-25-65

MISSISSIPPI
BOARD OF WATER COMMISSIONERS
416 North State Street
Jackson, Mississippi 39201

WATER WELL DRILLERS LOG


May 25 1965 65 Cahille Water Supply Jackson
date well completed firm name county well located

LANDOWNER: S. C. Mrs Beth
Map Point Main
(mailing address)
WELL LOCATION:
sec. 31 T 7 N R 5 E
Map Point
miles of (distance) (direction) (nearest town)

description of formations encountered	from	to
clay	0	22
sand	22	30
clay	30	44
sand	44	68

WELL PURPOSE: Home
(home, irrigation, municipal, industrial)


WELL COMPLETION DATA:
(1) diameter (inches) 1 1/4
(2) total depth (feet) 68
(3) static water level (feet) 12 ^{below} ~~above~~ top of ground.
(4) casing galv (material), (depth) _____
_____ if telescope see back.
(size) _____
(5) screen 5' (length), 123 (depth to top)
1 1/4 (size), Copper gauze (material)
(6) pump _____ (HP) _____ (yield gpm)
(type power) _____
(7) electric log no (yes or no)
(organization running log) _____
(8) how well bottom plugged B.P. O'Leary

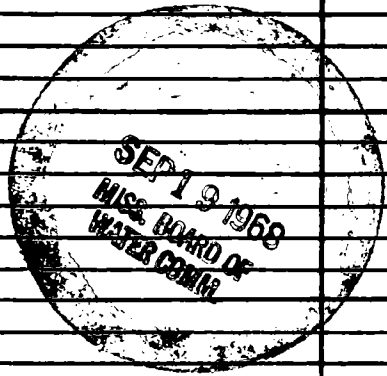

DRILLERS REMARKS: pump installed by owner

If well telescopes please sketch and show depths.

GROUND LEVEL

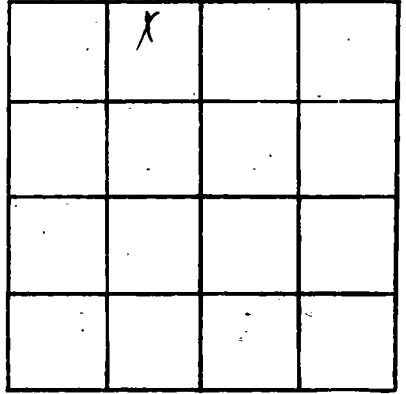

SECTION 31

Please indicate well location X.

ADDITIONAL INFORMATION

If more than one screen,
show locations of each on sketch.