

Jackson
Q 282
5-16-65

MISSISSIPPI
BOARD OF WATER COMMISSIONERS
416 North State Street
Jackson, Mississippi 39201

CODED

WATER WELL DRILLERS LOG

May 16 1965 Abvill Water Supply Jackson
date well completed firm name county well located

LANDOWNER: Dan Schmitz
Bayou Cambert Min
(mailing address)

description of formations encountered	from	to
<u>Clay</u>	<u>0</u>	<u>212</u>
<u>shale</u>	<u>212</u>	<u>154</u>
<u>clay</u>	<u>154</u>	<u>210</u>
<u>shale</u>	<u>210</u>	<u>271</u>

WELL LOCATION:
sec. 27 T 7 N R 5 E
3 miles east of Kreple
(distance) (direction) (nearest town)

WELL PURPOSE: home
(home, irrigation, municipal, industrial)

WELL COMPLETION DATA:
(1) diameter (inches) 6 3/4

(2) total depth (feet) 271

(3) static water level (feet) 23 (below/above top of ground)

(4) casing galv
(material) (depth)

(5) screen 20' 261
(length) (depth to top)


1 1/4 Copper Gauge
(size) (material)

(6) pump _____ (HP) _____ (yield gpm)

(7) electric log no
(yes or no)


(8) how well bottom plugged B.P. V. by

DRILLERS REMARKS: _____

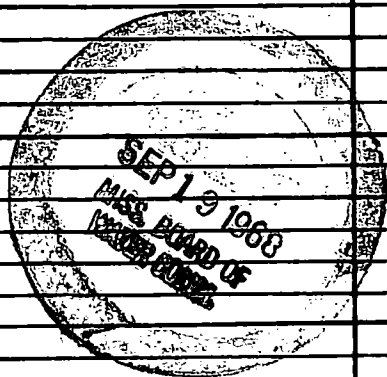

If well telescopes please sketch and show depths.

GROUND LEVEL

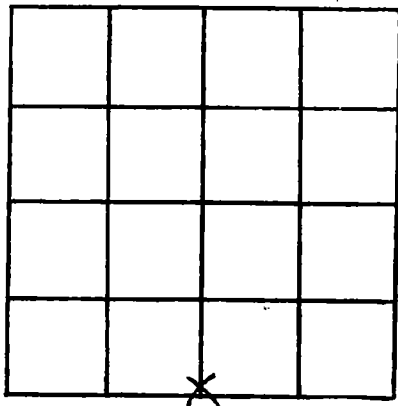

SECTION 27

Please indicate well location X.

ADDITIONAL INFORMATION

If more than one screen, show locations of each on sketch.