

Jackson  
 Q 283  
 5-21-65

MISSISSIPPI  
 BOARD OF WATER COMMISSIONERS  
 416 North State Street  
 Jackson, Mississippi 39201

**CODED**

WATER WELL DRILLERS LOG

May 21 1965 Colville Water Supply Jackson  
 date well completed firm name county well located


LANDOWNER: John  
Mart Hale  
Revan Min  
 (mailing address)

WELL LOCATION:  
 sec. 1 T. 7 N. R. 5 E  
5 miles NE of MP  
 (distance) (direction) (nearest town)

WELL PURPOSE: Home  
 (home, irrigation, municipal, industrial)

WELL COMPLETION DATA:  
 (1) diameter (inches) 1 1/4  
 (2) total depth (feet) 244  
 (3) static water level (feet) 9' below above top of ground.  
 (4) casing galv (material) (depth)  
 (size) If telescope see back.  
 (5) screen 10' 234 (length) (depth to top)  
1 1/4 Copper gauge (size) (material).  
 (6) pump (HP) (yield gpm)  
 (type power)  
 (7) electric log NO (yes or no)  
 (organization running log)  
 (8) how well bottom plugged B.P. Kelly


description of formations encountered	from	to
clay	0	70
sand	70	75
clay	95	130
sand	130	176
clay	176	220
sand	220	244

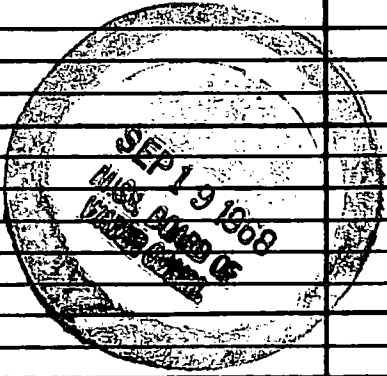

DRILLERS REMARKS: Drump  
controlled by owner

If well telescopes please sketch and show depths.

GROUND LEVEL

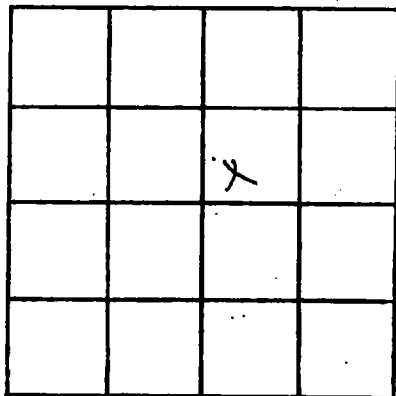

SECTION 1

Please indicate well location X.

ADDITIONAL INFORMATION

If more than one screen,  
show locations of each on sketch.