

Jackson
 Q284
 12-11-64

MISSISSIPPI
 BOARD OF WATER COMMISSIONERS
 416 North State Street
 Jackson, Mississippi 39201

INDEX

WATER WELL DRILLERS LOG

Dec 11 1964 Colville Water Sup Jackson
 date well completed firm name county well located


LANDOWNER:	description of formations encountered	from	to
<u>Jabe</u> <u>Cunningham</u> <u>Max Point</u> (mailing address)			

WELL LOCATION:
 sec 14 T N R E
S W
Max Point Miss
 (distance) miles (direction) (nearest town)

WELL PURPOSE: Drinking water
 (home, irrigation, municipal, industrial)

- WELL COMPLETION DATA:
- (1) diameter (inches) 1 1/4
 - (2) total depth (feet) 32
 - (3) static water level (feet) 15 ^{below} _{above} top of ground
 - (4) casing gal
 (material) (depth)
1 1/4
 (size) if telescope see back.
 - (5) screen 5' 2.7
 (length) (depth to top)
1 1/4 Open gauge
 (size) (material)
 - (6) pump _____ (HP) _____ (yield gpm)
 _____ (type power)
 - (7) electric log no
 (yes or no)
 _____ (organization running log)
 - (8) how well bottom plugged BP

DRILLERS REMARKS: pump installed by owner

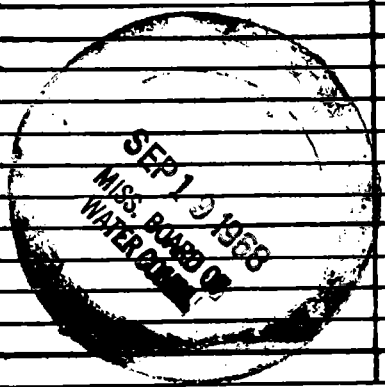

If well telescopes please sketch and show depths.

GROUND LEVEL

		<i>Grey</i>	

SECTION 16

Please indicate well location X.

ADDITIONAL INFORMATION

If more than one screen, show locations of each on sketch.