

Jackson
 Q285
 4-27-65

MISSISSIPPI
 BOARD OF WATER COMMISSIONERS
 416 North State Street
 Jackson, Mississippi 39201

CODED

WATER WELL DRILLERS LOG

March 27 1965 Chalk Water Supply Jackson
 Date well completed firm name county well located

LANDOWNER: Charles Bosarge
Pean Mine
 (mailing address)


description of formations encountered	from	to
<u>Clay</u>	<u>0</u>	<u>22</u>
<u>Gravel</u>	<u>22</u>	<u>135</u>

WELL LOCATION:
 sec. 14 T-7 N R-5 E
5 miles East of MP
 (distance) (direction) (nearest town)

WELL PURPOSE: Home
 (home, irrigation, municipal, industrial)

- WELL COMPLETION DATA:
- (1) diameter (inches) 1 1/4
 - (2) total depth (feet) 135
 - (3) static water level (feet) 3 below top of ground.
 - (4) casing galv (material) (depth) _____
 (size) if telescope see back.
 - (5) screen 5' 130 (length) (depth to top)
1 1/4 Copper galv (size) (material)
 - (6) pump _____ (HP) _____ (yield gpm)
 (type power) _____
 - (7) electric log no (yes or no)
 (organization running log) _____
 - (8) how well bottom plugged BPL

DRILLERS REMARKS: Installed by owner

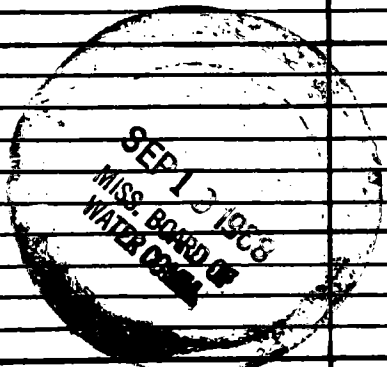

If well telescopes please sketch and show depths.

GROUND LEVEL

	X		

SECTION 17

Please indicate well location X.

ADDITIONAL INFORMATION

If more than one screen, show locations of each on sketch.