

Jackson
 Q286
 8-63

MISSISSIPPI
 BOARD OF WATER COMMISSIONERS
 416 North State Street
 Jackson, Mississippi 39201

CODED

WATER WELL DRILLERS LOG

Aug 20 1963 Libelle Water Supply Jackson
 date well completed firm name county well located

LANDOWNER: Bel Air Estates

description of formations encountered	from	to

Bayou Casotte, Miss.
 (mailing address)

Sand	0	21
Clay	21	63
Sand	63	70
Clay	70	84
Sand	84	127

WELL LOCATION:

sec. 17 T. 8 N. R. 5 E.
3 miles E of Lawrence
 (distance) (direction) (nearest town)

WELL PURPOSE: Irrigation
 (home, irrigation, municipal/industrial)

WELL COMPLETION DATA:

- (1) diameter (inches) 2"
- (2) total depth (feet) 127
- (3) static water level (feet) 17 ^{below} 17 _{above} top of ground.
- (4) casing galv 122
 (material) (depth)
2 (size) if telescope see back.
- (5) screen 5 122
 (length) (depth to top)
2" BR
 (size) (material)
- (6) pump _____
 (HP) (yield gpm)
 (type power)
- (7) electric log no
 (yes or no)
- (organization running log)
- (8) how well bottom plugged BR

CODED


MAR 10 1964

DRILLERS REMARKS: pump installed by owner

MISS. BU. OF
 WATER COMM.

If well telescopes please sketch and show depths.

GROUND LEVEL

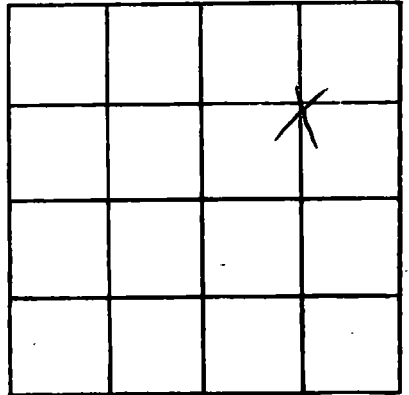

May 17
SECTION 17

Please indicate well location X.

ADDITIONAL INFORMATION

If more than one screen,
show locations of each on sketch.