

3-22-66

**CODED**

**MISSISSIPPI  
BOARD OF WATER COMMISSIONERS**  
416 North State Street  
Jackson, Mississippi 39201

**JACKSON**  
**Q 287**  
**3-22-66**

**WATER WELL DRILLERS LOG**

March 22 19 66 Colville Water Supply Co., Inc. Jackson  
date well completed firm name county well located

**LANDOWNER:** John W. Stark  
Pearl Miz  
(mailing address)

**WELL LOCATION:**  
sec. 6 T. 7 N. R. 4 E.  
12 miles E of M.P.  
(distance) (direction) (nearest town)

description of formations encountered	from	to
clay	0	22
sand	22	95
clay	95	150
sand	150	238

**WELL PURPOSE:** dom  
(home, irrigation, municipal, industrial)

**WELL COMPLETION DATA:**

(1) diameter (inches) 2"

(2) total depth (feet) 238

(3) static water level (feet) 6 below top of ground. above

(4) casing galv. 233  
(material) (depth)

\_\_\_\_\_ If telescope see back.  
(size)

(5) screen 5 233  
(length) (depth to top)

2" Stamper  
(size) (material)

(6) pump \_\_\_\_\_ (HP) \_\_\_\_\_ (yield gpm)

\_\_\_\_\_ (type power)

(7) electric log no  
(yes or no)

\_\_\_\_\_ (organization running log)


(8) how well bottom plugged BP  
Valve

**DRILLERS REMARKS:** pump installed by owner

MISS. BD. OF WATER COMM.

If well telescopes please sketch and show depths.

GROUND LEVEL

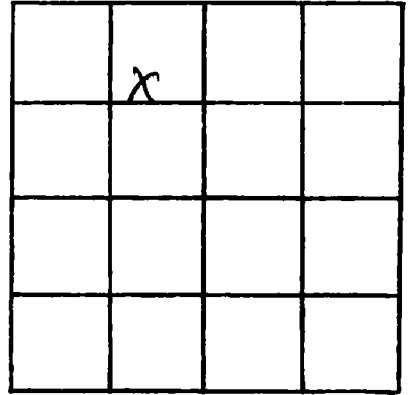

SECTION \_\_\_\_\_

Please indicate well location X.

ADDITIONAL INFORMATION

If more than one screen, show locations of each on sketch.