

**MISSISSIPPI
BOARD OF WATER COMMISSIONERS**
416 North State Street
Jackson, Mississippi 39201

CODED

WATER WELL DRILLERS LOG

JACKSON
Q 288
4-7-66

April 7 1966 Colville Water Supply Co., Inc. Jackson
date well completed firm name county well located

LANDOWNER: Standard Rentals
Boggs Casotte
(mailing address)

description of formations encountered	from to	
	feet	feet
Clay	0	22
Sand	22	36
Clay	36	97
Sand	97	107

WELL LOCATION:
sec. 7 T. 2 N. R. 5 E.
3 miles east of Parse
(distance) (direction) (nearest town)

WELL PURPOSE: ind
(home, irrigation, municipal, industrial)


- WELL COMPLETION DATA:
- (1) diameter (inches) 2"
 - (2) total depth (feet) 107
 - (3) static water level (feet) 21 ^{below} _{above} top of ground.
 - (4) casing Galv. 102
(material) (depth)
 - _____ If telescope see back.
(size)
 - (5) screen 5' 102
(length) (depth to top)
 - 2" plastic
(size) (material)
 - (6) pump _____
(HP) (yield gpm)
 - _____ (type power)
 - (7) electric log no
(yes or no)
 - _____ (organization running log)
 - (8) how well bottom plugged B.P. plug

DRILLERS REMARKS: pump installed by owner

MAR
MISS. BD. OF WATER COMMISSIONERS

If well telescopes please sketch and show depths.

GROUND LEVEL

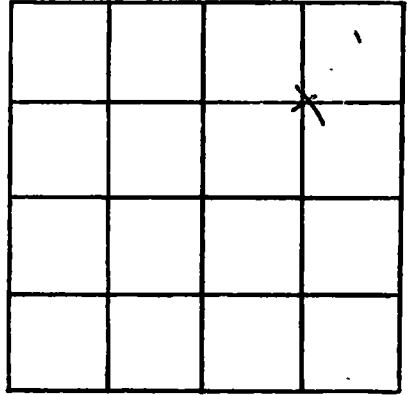

SECTION 7

Please indicate well location X.

ADDITIONAL INFORMATION

If more than one screen, show locations of each on sketch.