

1966

MISSISSIPPI  
BOARD OF WATER COMMISSIONERS  
416 North State Street  
Jackson, Mississippi 39201

CODED

WATER WELL DRILLERS LOG

JACKSON  
Q 289  
4-7-66

April 7 1966 Colville Water Supply Co. Inc. Jackson  
date well completed firm name county well located

LANDOWNER: John  
E. ngle 1401  
Mississippi Drive Pascagoula  
(mailing address)

description of formations encountered	from	to
	clay & sand streak	0
clay	18	08
fine sand	58	63
clay	63	100
sand	100	111

WELL LOCATION:  
T 8 N R 5 E  
Pascagoula  
miles of (distance) (direction) (nearest town)

WELL PURPOSE: irrigation  
(home, irrigation, municipal, industrial)

WELL COMPLETION DATA:

(1) diameter (inches) 2"

(2) total depth (feet) 111

(3) static water level (feet) 19 below top of ground.

(4) casing Galv. 106 (material) (depth) (size) If telescope see back.

(5) screen 5' 106 (length) (depth to top) 2" plastic (size) (material)

(6) pump (HP) (yield gpm) (type power)

(7) electric log no (yes or no) (organization running log) BP Water

(8) how well bottom plugged


MAR 20 1966

MISS. BD. OF WATER COM.

DRILLERS REMARKS: Pump installed by owner

if well telescopes please  
sketch and show depths.

GROUND LEVEL

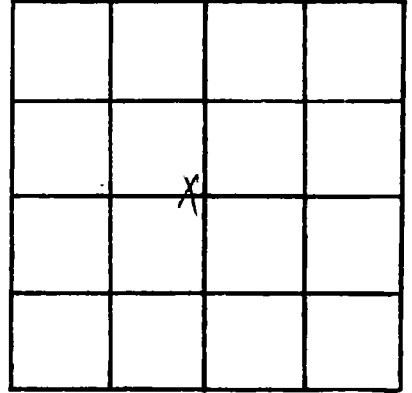

*irregular*  
SECTION 18

Please indicate well location X.

ADDITIONAL INFORMATION

If more than one screen,  
show locations of each on sketch.