

1966

CODED

MISSISSIPPI BOARD OF WATER COMMISSIONERS
416 North State Street
Jackson, Mississippi 39201

WATER WELL DRILLERS LOG

JACKSON
Q 290
4-8-66

April 8 1966 Colville Water Supply Co, Inc. Jackson
date well completed firm name County well located

LANDOWNER: Wallace
Construction Co.
Bayou Corotto
(mailing address)

description of formations encountered	depth	
	from	to
clay	0	22
sand	22	38
clay	38	60
gravel	60	69

WELL LOCATION:
sec. 7 T. 8 N. R. 5 E
3 miles east of Pass
(distance) (direction) (nearest town)

WELL PURPOSE: ind
(home, irrigation, municipal, industrial)

WELL COMPLETION DATA:

(1) diameter (inches) 2"

(2) total depth (feet) 69

(3) static water level (feet) 19 ^{below}/_{above} top of ground.

(4) casing galv. 64
(material) (depth)

(size) If telescope see back.

(5) screen 5 64
(length) (depth to top)

2" plaster
(size) (material)

(6) pump (HP) (yield gpm)

(type power)

(7) electric log no
(yes or no)

(organization running log)

(8) how well bottom plugged BPT/lor


DRILLERS REMARKS: pump
was called by customer

MAR 20 1966

MISS. BD. OF
WATER COMMISSIONERS

If well telescopes please sketch and show depths.

GROUND LEVEL

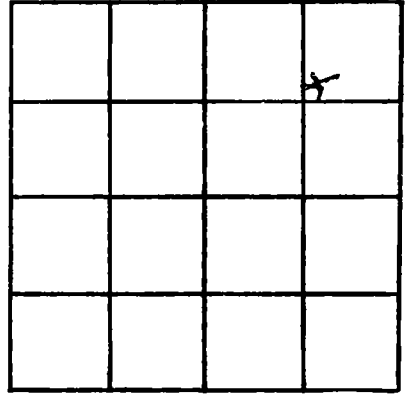

SECTION 7

Please indicate well location X.

ADDITIONAL INFORMATION

If more than one screen, show locations of each on sketch.