

EX-100

CODED

MISSISSIPPI
 BOARD OF WATER COMMISSIONERS
 416 North State Street
 Jackson, Mississippi 39201

WATER WELL DRILLERS LOG

JACKSON
 Q 291
 4-14-66

April 14 1966 date well completed Colville Water Supply Co. Inc. firm name Jackson county well located

LANDOWNER: <u>Ed [unclear]</u>	description of formations encountered	from	to
<u>Cumbert</u>			
<u>Pascagoula</u> (mailing address)	<u>clay and sand stone</u>	<u>0</u>	<u>22</u>
	<u>clay</u>	<u>22</u>	<u>60</u>
	<u>sand</u>	<u>60</u>	<u>84</u>

WELL LOCATION:
 sec. 18 T. 8 N. R. 5 E.
3 miles SE of Pascagoula
 (distance) (direction) (nearest town)

WELL PURPOSE: irrigation
 (home, irrigation, municipal, industrial)


- WELL COMPLETION DATA:
- (1) diameter (inches) 8
 - (2) total depth (feet) 84
 - (3) static water level (feet) 16 1/2 ^{below} above top of ground.
 - (4) casing galv 77
 (material) (depth)
 - _____ If telescope see back.
 (size)
 - (5) screen 5' 79
 (length) (depth to top)
 - 2' plastic
 (size) (material)
 - (6) pump _____
 (HP) (yield gpm)
 - _____ (type power)
 - (7) electric log no
 (yes or no)
 - _____ (organization running log)
 - (8) how well bottom plugged B.P. [unclear]

DRILLERS REMARKS: pumps installed by owner

MISS. BD. OF
 WATER COMM.

If well telescopes please sketch and show depths.

GROUND LEVEL

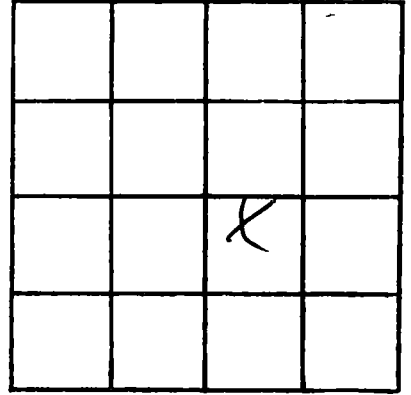

May 18
SECTION

Please indicate well location X.

ADDITIONAL INFORMATION

If more than one screen,
show locations of each on sketch.