

**MISSISSIPPI
BOARD OF WATER COMMISSIONERS**
416 North State Street
Jackson, Mississippi 39201

CODED

WATER WELL DRILLERS LOG

JACKSON
Q 292
3-22-69

March 22 1969 Colville Water Supply Co. Inc Jackson
date well completed firm name county well located

LANDOWNER: Church of the
Sord Jesus Christ
Helena, Missa
(mailing address)

WELL LOCATION:
sec. 6 T-7 N R-5 E
5 miles NE of M.P.
(distance) (direction) (nearest town)

description of formations encountered	depth	
	from	to
clay	0	10
sand	10	80
clay	80	144
sand	144	154
clay	154	194
mill	194	257

WELL PURPOSE: Church
(home, irrigation, municipal, industrial)

WELL COMPLETION DATA:

(1) diameter (inches) 2

(2) total depth (feet) 257

(3) static water level (feet) 9 below top of ground. above

(4) casing galv 252
(material) (depth)

_____ If telescope see back.
(size)

(5) screen 5' 252
(length) (depth to top)

2 concrete
(size) (material)

(6) pump _____
(HP) (yield gpm)

_____ (type power)

(7) electric log no
(yes or no)

_____ (organization running log)


(8) how well bottom plugged Bp Valve

DRILLERS REMARKS: pump installed by owner

1969
MISS. BD. OF
WATER COM.

If well telescopes please sketch and show depths.

GROUND LEVEL

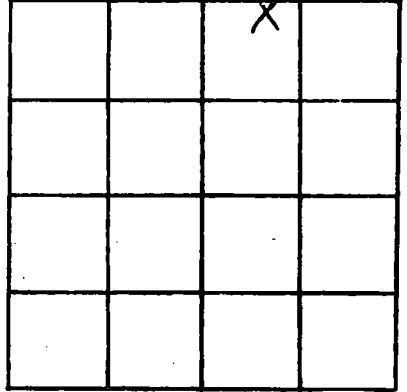

SECTION _____

Please indicate well location X.

ADDITIONAL INFORMATION

If more than one screen, show locations of each on sketch.