

Check with W.T.O.

JACKSON
Q 293
6-569

MISSISSIPPI
BOARD OF WATER COMMISSIONERS
416 North State Street
Jackson, Mississippi 39201

CODED

WATER WELL DRILLERS LOG

6-5 1969 Leape-Central Co. Jackson
date well completed firm name county well located

LANDOWNER: City of Pascagoula, Miss.

"
"
(mailing address)

description of formations encountered

	from	to
<u>Sandy Muddy Clay</u>	<u>0</u>	<u>15</u>
<u>Clay</u>	<u>15</u>	<u>40</u>
<u>Sand & Clay streaks</u>	<u>40</u>	<u>65</u>
<u>Sand</u>	<u>65</u>	<u>195</u>
<u>Clay w/ Sandy streaks</u>	<u>195</u>	<u>240</u>
<u>Sand</u>	<u>240</u>	<u>335</u>
<u>Clay</u>	<u>335</u>	<u>490</u>
<u>Sandy Clay</u>	<u>490</u>	<u>580</u>
<u>Sand</u>	<u>580</u>	<u>592</u>
<u>Clay w/ hard streaks</u>	<u>592</u>	<u>640</u>
<u>Sandy shale</u>	<u>640</u>	<u>762</u>
<u>Sand</u>	<u>762</u>	<u>787</u>
<u>Clay (lumpy)</u>	<u>787</u>	<u>813</u>
<u>Sandy Clay</u>	<u>813</u>	<u>838</u>

WELL LOCATION:
sec. 6 T. 8 S. R. 5 W.
Sears Parking Lot
W
miles of
(distance) (direction) (nearest town)

from to
0 15
15 40
40 65
65 195
195 240
240 335
335 490
490 580
580 592
592 640
640 762
762 787
787 813
813 838

WELL PURPOSE: Municipal
(home, irrigation, municipal, industrial)

WELL COMPLETION DATA:

- (1) diameter (inches) 12"
- (2) total depth (feet) 337'
- (3) static water level (feet) 62 below
top of ground. above
- (4) casing Steel, 246'
(material) (depth)
12"
(size) if telescope see back.
- (5) screen 80', 251'
(length) (depth to top)
8", Stainless Steel
(size) (material)
- (6) pump _____ (HP) _____ (yield gpm)
Electric
(type power)
- (7) electric log yes
(yes or no)
Y.S. & S.
(organization running log)
- (8) how well bottom plugged plug


DRILLERS REMARKS: Pump
Not installed as of
this date

JUN 20 1969

MISS. BD. OF
WATER COM.

If well telescopes please sketch and show depths.

GROUND LEVEL

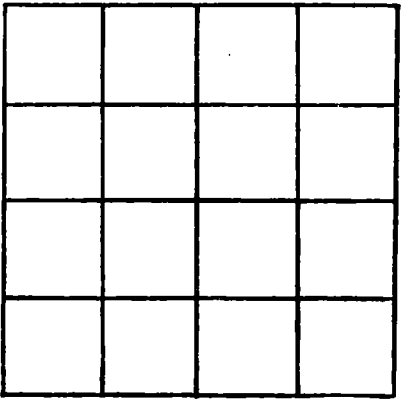

SECTION _____

Please indicate well location X.

ADDITIONAL INFORMATION

A series of horizontal lines for writing additional information, starting below the 'ADDITIONAL INFORMATION' header and extending to the bottom of the page.

If more than one screen, show locations of each on sketch.