

JACKSON  
Q 294  
~~5-3-66~~  
5-3-66

MISSISSIPPI  
BOARD OF WATER COMMISSIONERS  
416 North State Street  
Jackson, Mississippi 39201

CODED

WATER WELL DRILLERS LOG

May 3 1966 well completed  
Bohille White Supply firm name  
Jackson county well located

LANDOWNER: <u>Best Ballou</u> <u>Orange Grove</u> (mailing address)	description of formations encountered	from	to
	<u>Streaks of clay's sand</u>	<u>0</u>	<u>22</u>
	<u>sand</u>	<u>22</u>	<u>74</u>
	<u>clay</u>	<u>74</u>	<u>124</u>
	<u>sand</u>	<u>124</u>	<u>176</u>
WELL LOCATION: sec. <u>5</u> T. <u>7</u> N. R. <u>6</u> E. <u>10</u> miles <u>east</u> of <u>M.P.</u> (distance) (direction) (nearest town)			
WELL PURPOSE: <u>Home</u> (home, irrigation, municipal, industrial)			
WELL COMPLETION DATA: (1) diameter (inches) <u>2"</u> (2) total depth (feet) <u>176</u> (3) static water level (feet) <u>4'4"</u> <u>(below)</u> above top of ground. (4) casing <u>Galv</u> (material), (depth) (size) If telescope see back. (5) screen <u>5'</u> , <u>171</u> (length) (depth to top) <u>2"</u> , <u>Copper gauze</u> (size) (material) (6) pump (HP) (yield gpm) (type power) (7) electric log <u>no</u> (yes or no) (organization running log) (8) how well bottom plugged <u>B.P. Ochs</u>			
DRILLERS REMARKS: <u>Pump installed by owner</u>			


CODED

APR 21 1966

MISS. BD. OF  
WATER COMMISSIONERS

If well telescopes please sketch and show depths.

GROUND LEVEL

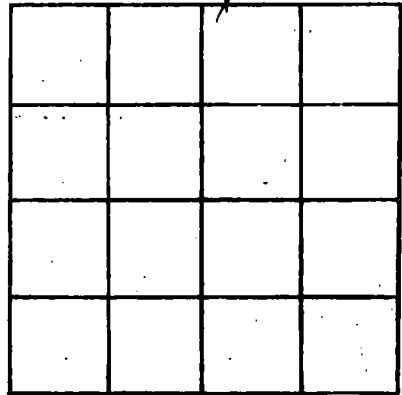

SECTION 5

Please indicate well location X.

ADDITIONAL INFORMATION

If more than one screen,  
show locations of each on sketch.