

Jackson
 Q295
 6-3-66

MISSISSIPPI
 BOARD OF WATER COMMISSIONERS
 416 North State Street
 Jackson, Mississippi 39201

CODED

WATER WELL DRILLERS LOG

June 3 1966 Colville Water Supply Jackson
 date well completed firm name county well located

LANDOWNER: <u>Rev. R. P. Parker</u>	description of formations encountered	from	to
<u>Helena, Miss</u> (mailing address)			
WELL LOCATION: sec. <u>6</u> T. <u>7</u> N. R. <u>5</u> E. <u>4</u> miles <u>N</u> of <u>M. Point</u> (distance) (direction) (nearest town)	<u>clay</u>	<u>0</u>	<u>22</u>
WELL PURPOSE: (home, irrigation, municipal, industrial)	<u>sand</u>	<u>22</u>	<u>69</u>
WELL COMPLETION DATA: (1) diameter (inches) <u>2</u>	<u>clay</u>	<u>64</u>	<u>126</u>
(2) total depth (feet) <u>246</u>	<u>fine sand</u>	<u>196</u>	<u>210</u>
(3) static water level (feet) <u>7</u> ^{below} above top of ground.	<u>sand</u>	<u>210</u>	<u>246</u>
(4) casing <u>galv</u> (material) (depth)			
(size) if telescope see back.			
(5) screen <u>5'</u> <u>24'</u> (length) (depth to top)			
<u>2"</u> <u>copper gauze</u> (size) (material)			
(6) pump (HP) (yield gpm)			
(type power)			
(7) electric log <u>no</u> (yes or no)			
(organization running log)			
(8) how well bottom plugged <u>BP Valve</u>			


APR 21 1969

DRILLERS REMARKS: pump installed by owner

MISS. BD. OF WATER COMM.

If well telescopes please sketch and show depths.

GROUND LEVEL

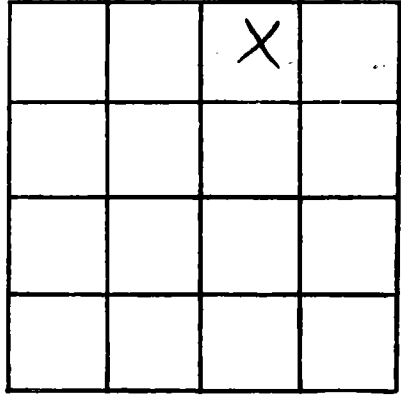

SECTION 6

Please indicate well location X.

ADDITIONAL INFORMATION

If more than one screen, show locations of each on sketch.