

**MISSISSIPPI
BOARD OF WATER COMMISSIONERS**
416 North State Street
Jackson, Mississippi 39201

CODED

WATER WELL DRILLERS LOG


Jackson
296
8-4-66

Aug 4 1966 Colville Water Supply Jackson
d. well completed firm name county well located

LANDOWNER: <u>A.B. Colburn</u>	description of formations encountered	from	to
<u>Nilma Miss</u> (mailing address)	<u>Clay</u>	<u>0</u>	<u>22</u>
WELL LOCATION: <u>4</u> sec <u>17</u> T <u>N</u> R <u>5</u> E <u>5</u> miles <u>N</u> of <u>Moss Point</u> (distance) (direction) (nearest town)	<u>Gravel</u>	<u>22</u>	<u>62</u>
WELL PURPOSE: <u>Home</u> (home, irrigation, municipal, industrial)	<u>Clay</u>	<u>62</u>	<u>176</u>
WELL COMPLETION DATA:	<u>Gravel</u>	<u>176</u>	<u>215</u>
(1) diameter (inches) <u>2"</u>	CODED		
(2) total depth (feet) <u>215</u>			
(3) static water level (feet) <u>12</u> ^(below) above top of ground.			
(4) casing <u>Galv</u> (material), _____ (depth), _____ (size) If telescope see back.			
(5) screen <u>5</u> (length), <u>210</u> (depth to top)			
<u>2'</u> (size), <u>Comp gauge</u> (material)			
(6) pump _____ (HP) _____ (yield gpm) _____ (type power)			
(7) electric log <u>no</u> (yes or no) _____ (organization running log)			
(8) how well bottom plugged <u>BPV plug</u>			
DRILLERS REMARKS: <u>Installed by owner</u>	APR 21 1969 MISS. Bd. OF WATER COMM.		

If well telescopes please sketch and show depths.

GROUND LEVEL

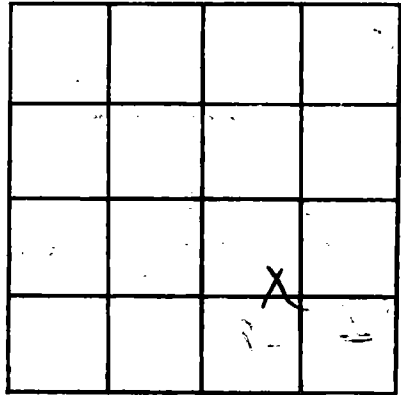

SECTION 4

Please indicate well location X.

ADDITIONAL INFORMATION

A series of horizontal lines for writing additional information, starting below the 'ADDITIONAL INFORMATION' header and extending to the bottom of the page.

If more than one screen, show locations of each on sketch.