

Jackson  
 Q300  
 1-20-67

MISSISSIPPI  
 BOARD OF WATER COMMISSIONERS  
 416 North State Street  
 Jackson, Mississippi 39201

CODED

WATER WELL DRILLERS LOG

Jan 20 1967 Delta Water Supply Jackson  
 date well completed firm name county well located

LANDOWNER: <u>Albert S</u>	description of formations encountered	from	to
<u>Merard - 1314 Eastwood Dr</u>			
<u>Pascagoula Miss</u> (mailing address)	<u>slush</u>	<u>0</u>	<u>6</u>
	<u>soft blue clay</u>	<u>6</u>	<u>30</u>
	<u>sand</u>	<u>30</u>	<u>165</u>
	<u>clay</u>	<u>165</u>	<u>167</u>
	<u>sand</u>	<u>167</u>	<u>180</u>
WELL LOCATION: sec. <u>11</u> T. <u>8</u> N. R. <u>5</u> E. <u>W</u> (distance) miles (direction) of <u>Pascagoula</u> (nearest town)			
WELL PURPOSE: (home, irrigation, municipal, industrial)			
WELL COMPLETION DATA:			
(1) diameter (inches) <u>3</u>			
(2) total depth (feet) <u>180</u>			
(3) static water level (feet) <u>236</u> Below top of ground above			
(4) casing <u>Plastic Coated galv.</u> (material) <u>170</u> (depth)			
(size) if telescope see back.			
(5) screen <u>10</u> (length) <u>170</u> (depth to top)			
<u>.010</u> (size) <u>Stamper Steel</u> (material)			
(6) pump (HP) (yield gpm)			
(type power)			
(7) electric log <u>no</u> (yes or no)			
(organization running log)			
(8) how well bottom plugged			


APR 21 1967

MISS. BD. OF  
 WATER COM.

DRILLERS REMARKS: Pumps furnished by owner

If well telescopes please sketch and show depths.

GROUND LEVEL

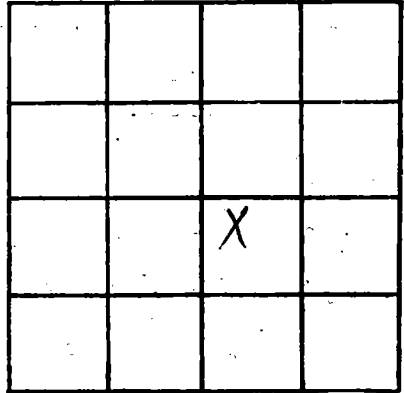

*Irreg*  
SECTION 11

Please indicate well location X.

ADDITIONAL INFORMATION

Lined area for additional information.

If more than one screen, show locations of each on sketch.