

JACKSON  
Q301  
2-10-67

MISSISSIPPI  
 BOARD OF WATER COMMISSIONERS CODED  
 416 North State Street  
 Jackson, Mississippi 39201

WATER WELL DRILLERS LOG

Feb 10 1967 Colville Water Sup Jackson  
 d - 3 well completed firm name county well located


LANDOWNER: <u>Gabe Morie</u>	description of formations encountered	from	to
<u>Franklin Creek</u> (mailing address)	<u>Sand - Gravel</u>	<u>12</u>	<u>22</u>
	<u>Sand</u>	<u>22</u>	<u>36</u>
	<u>clay</u>	<u>36</u>	<u>38</u>
	<u>sand</u>	<u>38</u>	<u>44</u>
	<u>clay</u>	<u>44</u>	<u>100</u>
	<u>sand</u>	<u>110</u>	<u>154</u>
WELL LOCATION: sec. <u>31</u> T. <u>9</u> N. R. <u>5</u> E. <u>10</u> miles <u>NE</u> of <u>MP</u> (distance) (direction) (nearest town)			
WELL PURPOSE: <u>home</u> (home, irrigation, municipal, industrial)			
WELL COMPLETION DATA:			
(1) diameter (inches) <u>2</u> "			
(2) total depth (feet) <u>154</u>			
(3) static water level (feet) <u>4.5</u> <u>below</u> above top of ground			
(4) casing <u>galv</u> (material) (depth)			
(size) If telescope see back.			
(5) screen <u>5'</u> <u>149</u> (length) (depth to top)			
<u>2"</u> <u>stainless</u> (size) (material)			
(6) pump (HP) (yield gpm)			
(type power)			
(7) electric log <u>no</u> (yes or no)			
(organization running log)			
(8) how well bottom plugged <u>B P Vaber</u>			
DRILLERS REMARKS: <u>Plumb</u> <u>installed by owner</u>			

APR 21 1969

MISS. BD. OF  
 WATER COMM.

If well telescopes please  
sketch and show depths.

GROUND LEVEL

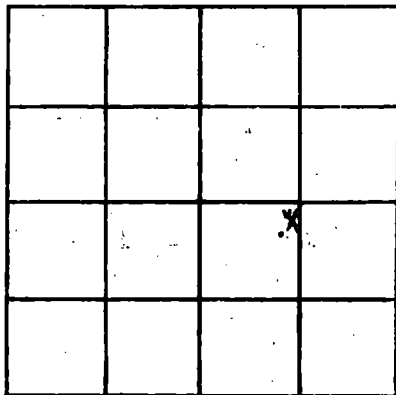

SECTION 31

Please indicate well location X.

ADDITIONAL INFORMATION

If more than one screen,  
show locations of each on sketch.