

Jackson  
 Q304  
 5-10-67

MISSISSIPPI  
 BOARD OF WATER COMMISSIONERS  
 416 North State Street  
 Jackson, Mississippi 39201

CODED

WATER WELL DRILLERS LOG

May 10 1967 Colville Water Sup Jackson  
 d. well completed firm name county well located

LANDOWNER: <u>Dr. M. Collins</u>	description of formations encountered	from	to
<u>Bellua Miss</u> (mailing address)	<u>Clay</u> <u>sand</u>	<u>6</u> <u>40</u>	<u>20</u> <u>50</u>
WELL LOCATION: sec. <u>34</u> T <u>6</u> N R <u>5</u> E <u>7</u> miles <u>NE</u> of <u>Moss Point</u> (distance) (direction) (nearest town)			
WELL PURPOSE: <u>Home</u> (home, irrigation, municipal, industrial)			
WELL COMPLETION DATA:			
(1) diameter (inches) <u>1 1/4</u>			
(2) total depth (feet) <u>50</u>			
(3) static water level (feet) <u>9</u> <u>below</u> above top of ground			
(4) casing <u>galv.</u> (material) (depth)			
(size) If telescope see back.			
(5) screen <u>51</u> (length) <u>45</u> (depth to top)			
<u>1 1/4</u> (size) <u>plastic</u> (material)			
(6) pump (HP) (yield gpm)			
(type power)			
(7) electric log <u>no</u> (yes or no)			
(organization running log)			
(8) how well bottom plugged <u>BP Valve</u>			
DRILLERS REMARKS:			


CODED

APR 21 1969

MISS. BD. OF  
 WATER COMM.

If well telescopes please sketch and show depths.

GROUND LEVEL

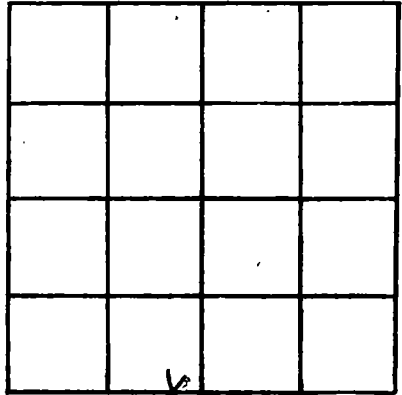

SECTION *34*

Please indicate well location X.

ADDITIONAL INFORMATION

If more than one screen, show locations of each on sketch.