

Jackson
 Q305
 5-20-67

MISSISSIPPI
 BOARD OF WATER COMMISSIONERS CODED
 416 North State Street
 Jackson, Mississippi 39201

WATER WELL DRILLERS LOG

May 20 1967 Chille Water Sup Jackson
 date well completed firm name county well located


LANDOWNER: <u>Mota Vehicle</u> <u>Controller of Miss</u> <u>Orange Grove</u> (mailing address)	description of formations encountered	from	to
	(old well) sand	221	244
	clay	244	352
	sand	352	363
WELL LOCATION: sec. <u>23</u> T. <u>7</u> N. R. <u>5</u> E <u>4 1/2</u> miles <u>out</u> of <u>MP</u> (distance) (direction) (nearest town)			
WELL PURPOSE: <u>truck wells</u> (home, irrigation, municipal, industrial)			
WELL COMPLETION DATA:			
(1) diameter (inches) <u>2</u> "			
(2) total depth (feet) <u>363</u>			
(3) static water level (feet) <u>20</u> <u>below</u> above top of ground			
(4) casing <u>galv</u> (material) _____ (depth) _____ (size) _____ if telescope see back.			
(5) screen <u>6</u> <u>357</u> (length) (depth to top)			
<u>2</u> <u>stainless</u> (size) (material)			
(6) pump <u>3/4</u> <u>7</u> (HP) (yield gpm)			
<u>elec</u> (type power)			
(7) electric log <u>no</u> (yes or no)			
_____ (organization running log)			
(8) how well bottom plugged <u>B.P. Pick</u>			
DRILLERS REMARKS:			

APR 21 1969

MISS. BD. OF
 WATER COMM.

If well telescopes please sketch and show depths.

GROUND LEVEL

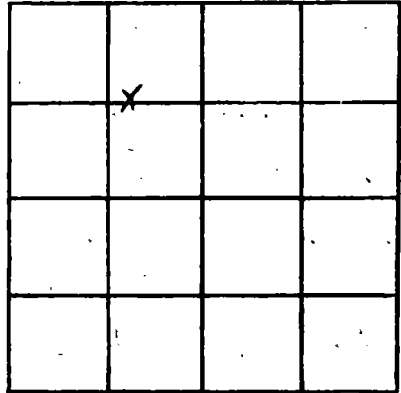

SECTION 23

Please indicate well location X.

ADDITIONAL INFORMATION

If more than one screen, show locations of each on sketch.