

Jackson
 9307
 8-16-67

MISSISSIPPI
 BOARD OF WATER COMMISSIONERS

416 North State Street
 Jackson, Mississippi 39201

WATER WELL DRILLERS LOG

Aug 16 19 67 Colwell Water Dry Jackson
 d. well completed firm name county well located

LANDOWNER: <u>L. H. Fountain</u>	description of formations encountered	from	to
<u>Byrd Casotte</u> (mailing address)	<u>2 1/2' sand</u> <u>soft blue clay</u> <u>sand</u>	<u>10</u> <u>42</u> <u>42</u>	<u>10</u> <u>42</u> <u>69</u>
WELL LOCATION: sec. <u>8</u> T. <u>8</u> N. R. <u>5</u> E. <u>3</u> miles <u>east</u> of <u>Pass</u> (distance) (direction) (nearest town)			
WELL PURPOSE: <u>Home</u> (home, irrigation, municipal, industrial)			
WELL COMPLETION DATA:			
(1) diameter (inches) <u>1 1/4</u>			
(2) total depth (feet) <u>69</u>			
(3) static water level (feet) <u>13</u> <u>below</u> above top of ground.			
(4) casing <u>galv</u> (material) (depth)			
_____ If telescope see back. (size)			
(5) screen <u>5</u> <u>141</u> (length) (depth to top).			
<u>1 1/4</u> (size) <u>plastic</u> (material)			
(6) pump _____ (HP) (yield gpm)			
_____ (type power)			
(7) electric log <u>NO</u> (yes or no)			
_____ (organization running log)			
(8) how well bottom plugged <u>B.P. Value</u>			
DRILLERS REMARKS: <u>Pump installed by owner</u>			


COPIED

APR 21 1989

MISS. BD. OF
 WATER COM.

If well telescopes please sketch and show depths.

GROUND LEVEL

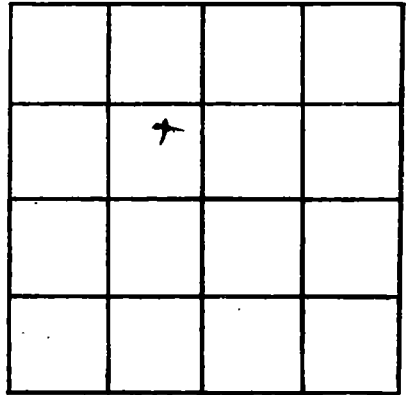

SECTION 8

Please indicate well location X.

ADDITIONAL INFORMATION

A series of horizontal lines for writing additional information, starting below the 'ADDITIONAL INFORMATION' header and extending to the bottom of the page.

If more than one screen, show locations of each on sketch.