

Jackson
 Q 308
 9-25-69

MISSISSIPPI
 BOARD OF WATER COMMISSIONERS
 416 North State Street
 Jackson, Mississippi 39201

CODED


WATER WELL DRILLERS LOG

9/25 1967 Colville Water Supply Jackson
 date well completed firm name county well located

LANDOWNER: <u>Lucy Mathews</u>	description of formations encountered	from	to
<u>Bayou Heron</u> (mailing address)	<u>clay</u>	0	12
WELL LOCATION: sec. <u>29</u> T <u>9</u> N R <u>4</u> E <u>5 1/2</u> miles <u>east</u> of <u>MP</u> (distance) (direction) (nearest town)	<u>sand</u>	12	48
WELL PURPOSE: <u>home</u> (home, irrigation, municipal, industrial)	CODED		
WELL COMPLETION DATA: (1) diameter (inches) <u>1 1/4</u> (2) total depth (feet) <u>48</u> (3) static water level (feet) <u>2</u> <u>below</u> above top of ground. (4) casing <u>galv</u> (material) (depth) (size) if telescope see back. (5) screen <u>5</u> <u>43</u> (length) (depth to top) <u>1 1/4</u> <u>plastic</u> (size) (material) (6) pump <u>1/2</u> <u>5</u> (HP) (yield gpm) <u>elec</u> (type power) (7) electric log <u>no</u> (yes or no) (organization running log) (8) how well bottom plugged <u>BP Vialy</u>			
DRILLERS REMARKS:	APR 21 1969	MISS. BD. OF WATER COMM.	

If well telescopes please sketch and show depths.

GROUND LEVEL

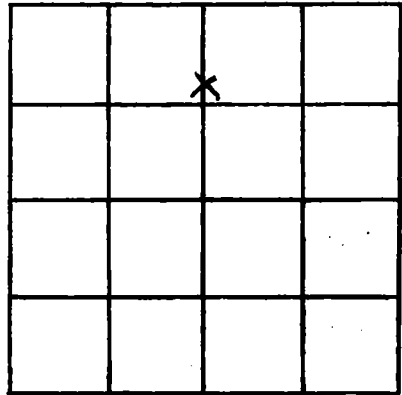

SECTION 29

Please indicate well location X.

ADDITIONAL INFORMATION

Lined area for additional information.

If more than one screen, show locations of each on sketch.