

Jackson
Q 309
10-6-67

MISSISSIPPI
 BOARD OF WATER COMMISSIONERS
 416 North State Street
 Jackson, Mississippi 39201 **CODED**

WATER WELL DRILLERS LOG

Oct 6 1967 Orville Water Sys Jackson
 date well completed firm name county well located

LANDOWNER: Robert Poole

description of formations encountered	from	to
<u>clay</u>	<u>0</u>	<u>12</u>
<u>sand</u>	<u>12</u>	<u>122</u>
<u>clay</u>	<u>122</u>	<u>176</u>
<u>sand</u>	<u>176</u>	<u>255</u>
<u>clay</u>	<u>255</u>	<u>308</u>
<u>sand</u>	<u>308</u>	<u>322</u>

Orange Grove Mine
 (mailing address)

WELL LOCATION:

sec. 23 T. 7 N. R. 5 E
5 1/2 miles East of M.P.
 (distance) (direction) (nearest town)

WELL PURPOSE: home
 (home, irrigation, municipal, industrial)

WELL COMPLETION DATA:

- (1) diameter (inches) 4
- (2) total depth (feet) 322
- (3) static water level (feet) 137 ^{below} above top of ground.
- (4) casing galv. (material) _____ (depth)
 _____ (size) If telescope see back.
- (5) screen 5 (length) 317 (depth to top)
2 (size) stainless (material)
- (6) pump 1/2 (HP) 7 (y/old gpm)
elc (type power)
- (7) electric log no (yes or no)

(organization running log)

(8) how well bottom plugged BP Valve


APR 27 1969

MISS. BD. OF
 WATER COMM.

DRILLERS REMARKS:

If well telescopes please sketch and show depths.

GROUND LEVEL

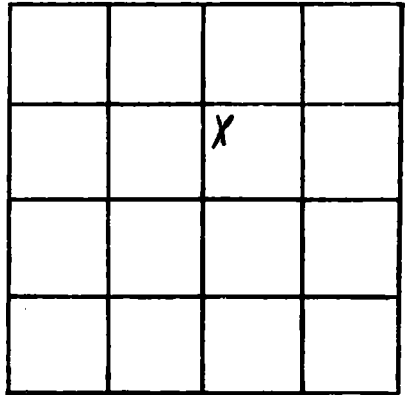

SECTION 23

Please indicate well location X.

ADDITIONAL INFORMATION

If more than one screen, show locations of each on sketch.