

Jackson  
B310  
1-3-68

MISSISSIPPI  
 BOARD OF WATER COMMISSIONERS  
 416 North State Street  
 Jackson, Mississippi 39201

CODED

WATER WELL DRILLERS LOG

Jan 3 1968 Colwell Water Sup Jackson  
 date well completed firm name county well located

LANDOWNER: <u>Bill Johnson</u>	description of formations encountered	from	to
<u>Bryan Lambert</u> (mailing address)			
WELL LOCATION: sec <u>36</u> T <u>7</u> N R <u>5</u> E <u>5</u> miles <u>east</u> of <u>MP</u> (distance) (direction) (nearest town)	<u>sand</u>	<u>0</u>	<u>50</u>
WELL PURPOSE: <u>home</u> (home, irrigation, municipal, industrial)	<u>clay</u>	<u>50</u>	<u>52</u>
WELL COMPLETION DATA: (1) diameter (inches) <u>2</u>	<u>sand</u>	<u>52</u>	<u>176</u>
(2) total depth (feet) <u>264</u>	<u>clay</u>	<u>176</u>	<u>216</u>
(3) static water level (feet) <u>29</u> <u>below</u> top of ground.	<u>sand</u>	<u>216</u>	<u>264</u>
(4) casing <u>galv</u> (material) (depth) _____ (size) if telescope see back.			
(5) screen <u>4</u> , <u>260</u> (length) (depth to top)			
<u>2</u> , <u>stainless</u> (size) (material)			
(6) pump <u>3/4</u> , <u>8</u> (HP) (yield gpm) <u>elec</u> (type power)			
(7) electric log <u>no</u> (yes or no)			
(organization running log) _____			
(8) how well bottom plugged <u>BPU</u>			
DRILLERS REMARKS:			


CODED

APR 21 1969

MISS. BD. OF  
 WATER COMMISSIONERS

If well telescopes please sketch and show depths.

GROUND LEVEL

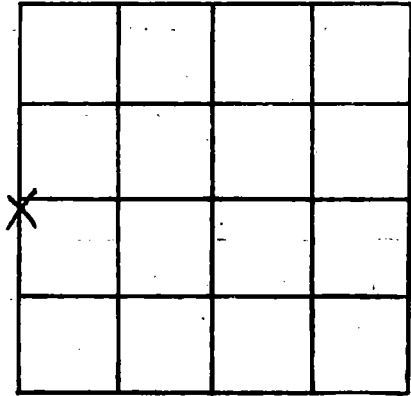

SECTION 36

Please indicate well location X.

ADDITIONAL INFORMATION

A series of horizontal lines for writing additional information.

If more than one screen, show locations of each on sketch.