

Jackson
 Q 316
 4-6-70

MISSISSIPPI
 BOARD OF WATER COMMISSIONERS
 416 North State Street
 Jackson, Mississippi 39201

CODED

WATER WELL DRILLERS LOG

April 6 1970 *Colville Water Supply* Jackson
 date well completed firm name county well located


LANDOWNER: <i>J. H. King</i>	description of formations encountered	from	to
<i>King</i>	<i>clay</i>	0	10
<i>Melina Min</i> (mailing address)	fine sand	10	90
WELL LOCATION: 006	<i>clay</i>	90	118
5 sec. T 7 N R 5 E	<i>fine sand</i>	118	163
6 miles NE of <i>More Point</i>	<i>fine sand & clay streak</i>	163	237
(distance) (direction) (nearest town)	fine sand	237	258
WELL PURPOSE: (home, irrigation, municipal, industrial)			
WELL COMPLETION DATA:			
(1) diameter (inches) <i>2</i>			
(2) total depth (feet) <i>258</i>			
(3) static water level (feet) <i>16-6</i> ^{below} / _{above} top of ground.			
(4) casing <i>galv.</i> <i>253</i> (material) (depth)			
(size) If telescope see back.			
(5) screen <i>5'</i> <i>253</i> (length) (depth to top)			
<i>2</i> <i>stainless</i> (size) (material)			
(6) pump _____ (HP) (yield gpm)			
(type power)			
(7) electric log <i>no</i> (yes or no)			
(organization running log)			
(8) how well bottom plugged <i>B.P. Valve</i>			
DRILLERS REMARKS: <i>spring installed by owner</i>			

MAY 14 1970

MISS. BD. OF
 WATER COMM.

If well telescopes please sketch and show depths.

GROUND LEVEL

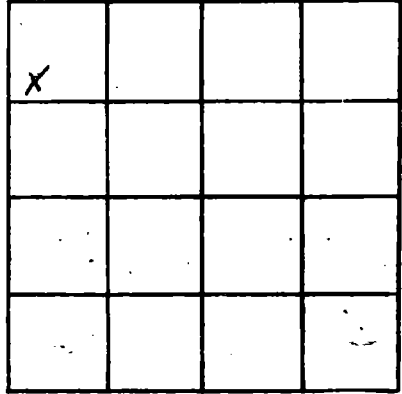

SECTION 5

Please indicate well location X.

ADDITIONAL INFORMATION

If more than one screen, show locations of each on sketch.