

Jackson
 Q 317
 2-18-69

MISSISSIPPI
 BOARD OF WATER COMMISSIONERS
 416 North State Street
 Jackson, Mississippi 39201

CODED

WATER WELL DRILLERS LOG

Feb 18 1969 Colville Water Supply Jackson
 date well completed firm name county well located


LANDOWNER: <u>Arnold Lee Mahathy</u> <u>Orange Grove M.</u> (mailing address)	description of formations encountered <u>Sandy clay</u> <u>clay</u> <u>shred</u>	from	to
		<u>0</u>	<u>71</u>
		<u>71</u>	<u>95</u>
		<u>95</u>	<u>106</u>
WELL LOCATION: sec. <u>22</u> <u>T 7</u> <u>N</u> R. <u>5</u> <u>E</u> <u>4</u> miles <u>East</u> of <u>MP</u> (distance) (direction) (nearest town)			
WELL PURPOSE: <u>home</u> (home, irrigation, municipal, industrial)			
WELL COMPLETION DATA:			
(1) diameter (inches) <u>2</u>			
(2) total depth (feet) <u>106</u>			
(3) static water level (feet) <u>4' 9"</u> <u>below</u> above top of ground.			
(4) casing <u>galv</u> (material), (depth), (size) if telescope see back.			
(5) screen <u>4</u> (length), <u>102</u> (depth to top) <u>2</u> (size), <u>plastic</u> (material)			
(6) pump <u>1/2</u> (HP), <u>6</u> (yield gpm) <u>elec</u> (type power)			
(7) electric log <u>no</u> (yes or no) (organization running log)			
(8) how well bottom plugged <u>B.P. Mahathy</u>			
DRILLERS REMARKS:			

JAN - 8 1970

MISS. BD. OF
 WATER COMM.

If well telescopes please sketch and show depths.

GROUND LEVEL

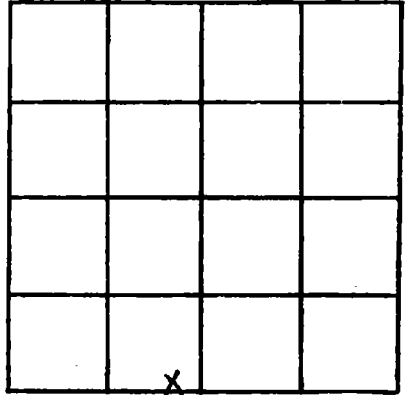

SECTION 22

Please indicate well location X.

ADDITIONAL INFORMATION

If more than one screen,
show locations of each on sketch.