

Jackson
 Q 321.
 9-30-68

MISSISSIPPI
 BOARD OF WATER COMMISSIONERS
 416 North State Street
 Jackson, Mississippi 39201

CODED

WATER WELL DRILLERS LOG

Sept 30 1968 Osborne Water Pump Jackson
 date well completed firm name county well located


LANDOWNER: <u>by Miller</u>	description of formations encountered	from	to
<u>Bayou Lumbert</u> (mailing address)	<u>soft clay</u>	0	40
	<u>sand</u>	40	66
	<u>clay</u>	66	90
	<u>sand</u>	90	126
	<u>clay</u>	126	198
	<u>slud</u>	198	271
WELL LOCATION: sec. <u>27</u> T <u>7</u> N R <u>5</u> E <u>3 1/2</u> miles <u>SE</u> of <u>MP</u> (distance) (direction) (nearest town)			
WELL PURPOSE: <u>home</u> (home, irrigation, municipal, industrial)			
WELL COMPLETION DATA:			
(1) diameter (inches) <u>2</u>			
(2) total depth (feet) <u>271</u>			
(3) static water level (feet) <u>33</u> ^{below} _{above} top of ground.			
(4) casing <u>galv</u> (material) (depth) (size) if telescope see back.			
(5) screen <u>4'</u> <u>267</u> (length) (depth to top)			
<u>2</u> <u>stainless</u> (size) (material)			
(6) pump <u>1/2</u> <u>5</u> (HP) (yield gpm)			
<u>elec</u> (type power)			
(7) electric log <u>no</u> (yes or no)			
(organization running log)			
(8) how well bottom plugged <u>BP Valve</u>			
DRILLERS REMARKS:			

JAN 8 1970

MISS. DD. OF
 WATER COMM.

If well telescopes please sketch and show depths.

GROUND LEVEL

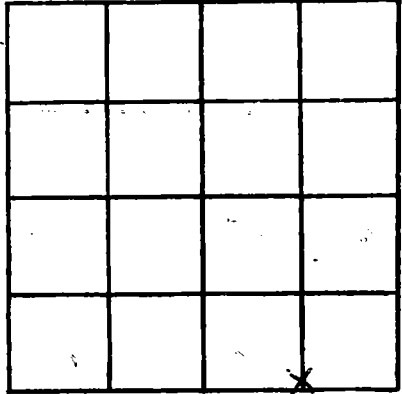

SECTION 

Please indicate well location X.

ADDITIONAL INFORMATION

If more than one screen, show locations of each on sketch.