

Jackson

Q 322

1-20-70

MISSISSIPPI
 BOARD OF WATER COMMISSIONERS
 416 North State Street
 Jackson, Mississippi 39201

CODED

WATER WELL DRILLERS LOG

Jan 20 1970 Colwell Water Supply Jackson
 date well completed firm name county well located

LANDOWNER: W. H. Stanley

Orange Grove
(mailing address)

WELL LOCATION:

sec. 23 T 7 N R. 5 E
4 miles East of M.P.
 (distance) (direction) (nearest town)

WELL PURPOSE: Home
 (home, irrigation, municipal, industrial)

WELL COMPLETION DATA:

- (1) diameter (inches) 2
- (2) total depth (feet) 336
- (3) static water level (feet) 16-10 ^{below} above top of ground.
- (4) casing galv. (material), (depth) _____
 (size) If telescope see back.
- (5) screen 5', 331 (length), (depth to top)
2 (size), stainless (material)
- (6) pump 1/2 (HP), 6 (yield gpm)
elec (type power)
- (7) electric log no (yes or no)
 (organization running log)
- (8) how well bottom plugged BP Valve

| description of formations encountered | from | to |
|---------------------------------------|------|-----|
| Clay | 0 | 2 |
| sand | 2 | 75 |
| clay | 75 | 88 |
| sand | 88 | 130 |
| clay | 130 | 168 |
| sand | 168 | 260 |
| gritty sand and clay streaks | 260 | 328 |
| sand | 328 | 336 |


FEB 27 1970

MISS. BD. OF WATER CO.

DRILLERS REMARKS:

If well telescopes please sketch and show depths.

GROUND LEVEL

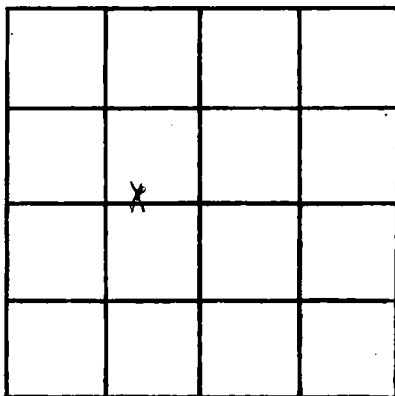

SECTION 23

Please indicate well location X.

ADDITIONAL INFORMATION

If more than one screen, show locations of each on sketch.