

Jackson
 Q 323
 2-4-70

MISSISSIPPI
 BOARD OF WATER COMMISSIONERS
 416 North State Street
 Jackson, Mississippi 39201
 WATER WELL DRILLERS LOG

COPIED

Feb 4 1970 Colville Water Sup. Jackson
 date well completed firm name county well located

LANDOWNER: W. J. Kirkland
 Orange Grove Miss
 (mailing address)

description of formations encountered	from	to
Clay	0	10
hard clay	10	90
clay	90	125
sand	125	155

WELL LOCATION:
 sec. 6 T. 7 N R. 4 E
 6 miles N.E. of M.P.
 (distance) (direction) (nearest town)

WELL PURPOSE: home
 (home, irrigation, municipal, industrial)

- WELL COMPLETION DATA:
- diameter (inches) 3
 - total depth (feet) 155
 - static water level (feet) 4 ^{below} _{above} top of ground.
 - casing galv (material), (depth)
 (size) If telescope see back.
 - screen 5 (length), 150 (depth to top)
 2 (size), stainless (material)
 - pump (HP) (yield gpm)
 (type power)
 - electric log no (yes or no)
 (organization running log)
 - how well bottom plugged B. P. Vahy


FEB 27 1970

MISS. BD. OF
 WATER COMM.

DRILLERS REMARKS: install pump

If well telescopes please sketch and show depths.

GROUND LEVEL

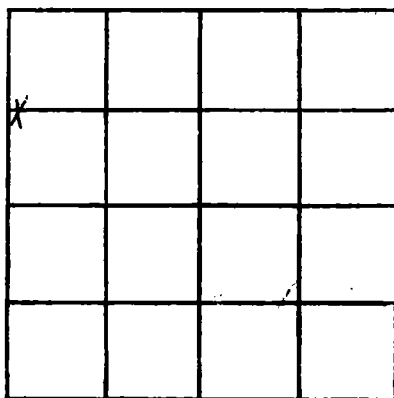

SECTION 6

Please indicate well location X.

ADDITIONAL INFORMATION

Lined area for additional information.

If more than one screen, show locations of each on sketch.