

JACKSON
 Q 326
 7-27-70

MISSISSIPPI
 BOARD OF WATER COMMISSIONERS
 416 North State Street
 Jackson, Mississippi 39201

CODED

WATER WELL DRILLERS LOG

July 27 1970 Cobble Water Supply Jackson
 Date well completed firm name county well located

LANDOWNER: <u>R. C. Neal</u>	description of formations encountered	from	to
Bayou Lambert, Miss (mailing address)	pipe clay pipe clay sand	0 5 14	5 14 153
WELL LOCATION: sec. <u>35</u> T <u>7</u> N R <u>5</u> E <u>5</u> miles <u>SE</u> of <u>MP</u> (distance) (direction) (nearest town)	clay sand	153 210	210 258
WELL PURPOSE: <u>home</u> (home, irrigation, municipal, industrial)			
WELL COMPLETION DATA: (1) diameter (inches) <u>2"</u> (2) total depth (feet) <u>258</u> (3) static water level (feet) <u>30</u> below above top of ground. (4) casing <u>galv</u> <u>273</u> (material) (depth) ____ if telescope see back. (size) (5) screen <u>5</u> <u>253</u> (length) (depth to top) <u>2</u> <u>stainless</u> (size) (material) (6) pump <u>1/2</u> <u>6</u> (HP) (yield gpm) <u>elec</u> (type power) (7) electric log <u>no</u> (yes or no) ____ (organization running log) (8) how well bottom plugged <u>BPO Vahl</u>			
DRILLERS REMARKS:			


CODED

SEP 11 1970

MISS. BD. OF
 WATER COMM.

If well telescopes please sketch and show depths.

GROUND LEVEL

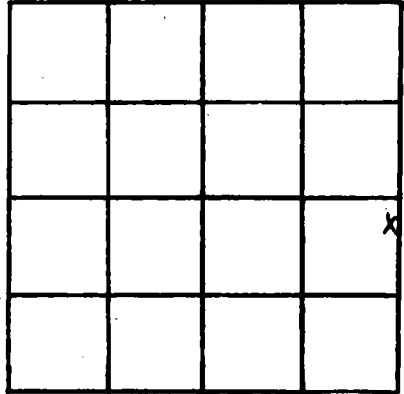

SECTION _____

Please indicate well location X.

ADDITIONAL INFORMATION

If more than one screen, show locations of each on sketch.