

JACKSON

Q327

8-5-70

MISSISSIPPI
 BOARD OF WATER COMMISSIONERS
 416 North State Street
 Jackson, Mississippi 39201

CODED

WATER WELL DRILLERS LOG

Aug 5 1970 Palmetto Water Supply, Jackson
 date well completed firm name county well located

LANDOWNER: Wilboyn

LEDLOW

Leban, Miss
 (mailing address)

WELL LOCATION:

sec. 18 T. 7 N. R. 5 E
 7 1/2 miles East of MP
 (distance) (direction) (nearest town)

WELL PURPOSE: Home
 (home, irrigation, municipal, industrial)

WELL COMPLETION DATA:

- (1) diameter (inches) 2
- (2) total depth (feet) 170
- (3) static water level (feet) 12 ^{below} above top of ground.
- (4) casing Galv 165
 (material) (depth)
- If telescope see back.
 (size)
- (5) screen 5' 165
 (length) (depth to top)
- 2" plumber
 (size) (material)
- (6) pump 1/2 5
 (HP) (yield gpm)
- elec
 (type power)
- (7) electric log no
 (yes or no)

(organization running log)

(8) how well bottom plugged BSV

| description of formations encountered | from | to |
|---------------------------------------|------------|------------|
| <u>old hole</u> | <u>0</u> | <u>48</u> |
| <u>subgravel</u> | <u>48</u> | <u>80</u> |
| <u>clay</u> | <u>80</u> | <u>153</u> |
| <u>shud</u> | <u>153</u> | <u>170</u> |

CODED


SEP 11 1970

DRILLERS REMARKS:

MISS. BD. OF
WATER COMM.

If well telescopes please sketch and show depths.

GROUND LEVEL

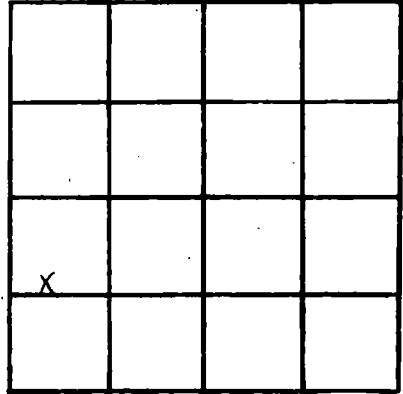

SECTION _____

Please indicate well location X.

ADDITIONAL INFORMATION

A series of horizontal lines for writing additional information, starting below the 'ADDITIONAL INFORMATION' header and extending to the bottom of the page.

If more than one screen, show locations of each on sketch.