

JACKSON
 Q 328
 7-25-70

MISSISSIPPI
 BOARD OF WATER COMMISSIONERS
 416 North State Street
 Jackson, Mississippi 39201

INDEXED

WATER WELL DRILLERS LOG

July 25 1970 Colville Water Supply Jackson
 date well completed firm name county well located

LANDOWNER: <u>Joseph Patrick</u>	description of formations encountered	from	to
<u>Orange Grove Miss</u> (mailing address)	<u>clay</u>	<u>0</u>	<u>10</u>
WELL LOCATION: sec. <u>23</u> T <u>7</u> N R <u>5</u> E <u>6</u> miles <u>east</u> of <u>M.P.</u> (distance) (direction) (nearest town)	<u>sand</u>	<u>10</u>	<u>110</u>
WELL PURPOSE: <u>home</u> (home, irrigation, municipal, industrial)	<u>clay</u>	<u>110</u>	<u>152</u>
WELL COMPLETION DATA: (1) diameter (inches) <u>2"</u> (2) total depth (feet) <u>236</u> (3) static water level (feet) <u>24</u> <u>below</u> above top of ground. (4) casing <u>galv</u> , <u>231</u> (material) (depth) (size) If telescope see back. (5) screen <u>5'</u> , <u>231</u> (length) (depth to top) <u>2"</u> , <u>stainless</u> (size) (material) (6) pump <u>0</u> <u></u> (HP) (yield gpm) (type power) (7) electric log <u>no</u> (yes or no) (organization running log) (8) how well bottom plugged <u>B.P. Value</u>	<u>sand</u>	<u>152</u>	<u>236</u>
DRILLERS REMARKS:			


INDEXED

SEP 11 1970

MISS. BD. OF
 WATER COMM.

If well telescopes please sketch and show depths.

GROUND LEVEL

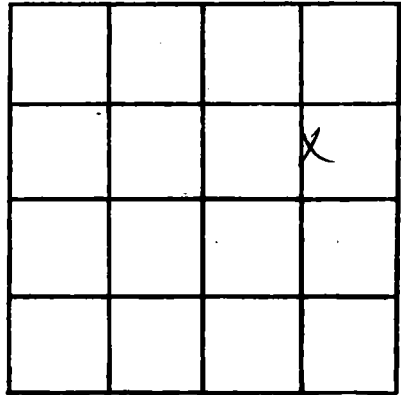

SECTION 23

Please indicate well location X.

ADDITIONAL INFORMATION

If more than one screen, show locations of each on sketch.