

JACKSON
 Q 331
 9-15-70

MISSISSIPPI
 BOARD OF WATER COMMISSIONERS
 416 North State Street
 Jackson, Mississippi 39201

CODED

WATER WELL DRILLERS LOG

Sept 15 1970 Phillips Water Supply Jackson
 date well completed firm name county well located

LANDOWNER: <u>J. C. Woods</u>	description of formations encountered	from	to
<u>Orange Grove</u> (mailing address)			
WELL LOCATION: sec. <u>23</u> T- <u>7</u> N R- <u>5</u> E <u>4 1/2</u> miles <u>East</u> of <u>MP</u> (distance) (direction) (nearest town)	<u>clay</u>	<u>0</u>	<u>18</u>
	<u>sand</u>	<u>18</u>	<u>131</u>
	<u>clay with mud streaks</u>	<u>131</u>	<u>152</u>
	<u>clay</u>	<u>152</u>	<u>165</u>
	<u>sand</u>	<u>165</u>	<u>215</u>

WELL PURPOSE: home
 (home, irrigation, municipal, industrial)

- WELL COMPLETION DATA:
- diameter (inches) 2
 - total depth (feet) 215
 - static water level (feet) 24 ^{below} above top of ground.
 - casing galv. 210
 (material) (depth)
 (size) If telescope see back.
 - screen 5' 210
 (length) (depth to top)
2" stainless
 (size) (material)
 - pump 1/2 7
 (HP) (yield gpm)
elec
 (type power)
 - electric log no
 (yes or no)
 - (organization running log)
 - how well bottom plugged BPU Valve

CODED


OCT 14 1970

DRILLERS REMARKS: _____

MISS. BD. OF WATER COMMISSIONERS

If well telescopes please sketch and show depths.

GROUND LEVEL

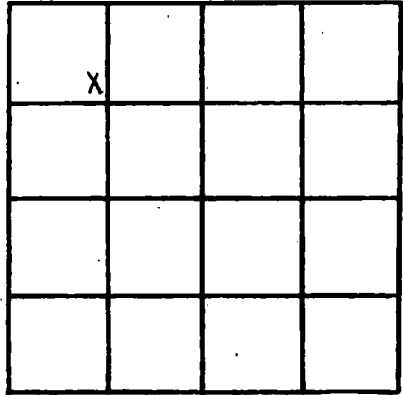

SECTION 22

Please indicate well location X.

ADDITIONAL INFORMATION

A series of horizontal lines provided for entering additional information.

If more than one screen, show locations of each on sketch.