

JACKSON
 Q332
 9-18-70

MISSISSIPPI
 BOARD OF WATER COMMISSIONERS
 416 North State Street
 Jackson, Mississippi 39201

CODED

WATER WELL DRILLERS LOG

Sept 18 1970 date well completed
 BPO Water Supply firm name
 Jackson county well located

LANDOWNER:	description of formations encountered	from	to
Pearley Ray Jones Orange Brook (mailing address)			
WELL LOCATION: sec. 23 T-? N R-5 E 4 1/2 miles east of MP (distance) (direction) (nearest town)			
WELL PURPOSE: home (home, irrigation, municipal, industrial)			
WELL COMPLETION DATA:			
(1) diameter (inches) 2			
(2) total depth (feet) 215			
(3) static water level (feet) 24 below top of ground.			
(4) casing Galv, 210 (material) (depth)			
(size) If telescope see back.			
(5) screen 5 210 (length) (depth to top)			
2" stainless (size) (material)			
(6) pump 1/2 5 (HP) (yield gpm)			
elec (type power)			
(7) electric log no (yes or no)			
(organization running log)			
(8) how well bottom plugged BPO blue			

CODED


OCT 14 1970

MISS. BD. OF
 WATER COMMISSIONERS

DRILLERS REMARKS:

If well telescopes please sketch and show depths.

GROUND LEVEL

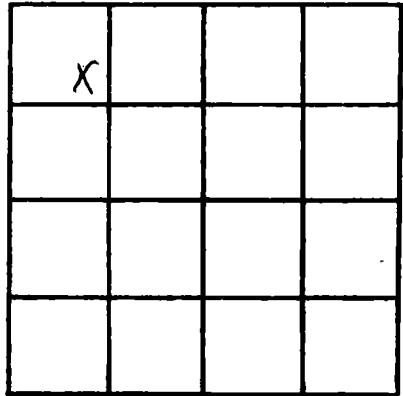

SECTION 23

Please indicate well location X.

ADDITIONAL INFORMATION

If more than one screen, show locations of each on sketch.