

JACKSON

Q335

9-29-70

MISSISSIPPI BOARD OF WATER COMMISSIONERS
416 North State Street
Jackson, Mississippi 39201

CODED

WATER WELL DRILLERS LOG

Sept 29 1970
date well completed

Colville Water Supply
firm name

Jackson
county well located

LANDOWNER: Mrs. E. A. Alexander

description of formations encountered

from to

Orange Grove
(mailing address)

Clay	0	19
sand	19	60
Clay	60	64
sand	64	173
Clay	173	194
sand	194	215
streaks of sand and clay	215	230
Clay	230	236
streaks	236	299
Clay	299	320
streaks	320	325
sand	325	362

WELL LOCATION:

sec. 6 T 7 N R 4 E
7 miles NE of MP
(distance) (direction) (nearest town)

WELL PURPOSE: home
(home, irrigation, municipal, industrial)

WELL COMPLETION DATA:

- (1) diameter (inches) 2
- (2) total depth (feet) 362
- (3) static water level (feet) 17 below top of ground
- (4) casing galv. 357 (material) (depth)
- (size) If telescope see back.
- (5) screen 5 357 (length) (depth to top)
- 2 stainless (size) (material)
- (6) pump (HP) (yield gpm)
- (type power)
- (7) electric log no (yes or no)

(organization running log)

(8) how well bottom plugged B.P. value

CODED


OCT 14 1970

MISS. BD. OF WATER COMM.

DRILLERS REMARKS: pump installed by owner

If well telescopes please sketch and show depths.

GROUND LEVEL

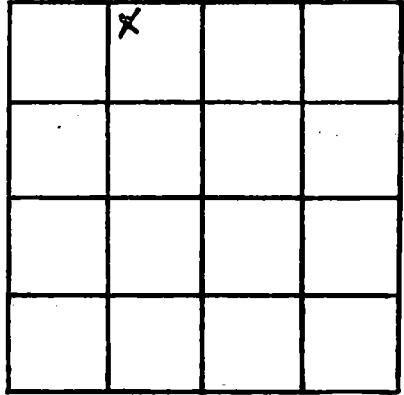

SECTION 6

Please indicate well location X.

ADDITIONAL INFORMATION

If more than one screen, show locations of each on sketch.