

JACKSON  
 Q 336  
 10-9-70

MISSISSIPPI  
 BOARD OF WATER COMMISSIONERS  
 416 North State Street  
 Jackson, Mississippi 39201

**CODED**

WATER WELL DRILLERS LOG

Oct 9 1970 Cobille Water Supply Jackson  
 date well completed firm name county well located

LANDOWNER: <u>Veater</u>	description of formations encountered	from	to
<u>Pierce</u>	<u>clay</u>	<u>0</u>	<u>15</u>
<u>Orange Grove</u> (mailing address)	<u>sand &amp; gravel</u>	<u>15</u>	<u>144</u>
WELL LOCATION: sec. <u>23 T 7 N</u> R. <u>5 E</u>	<u>clay streaks and clay</u>	<u>144</u>	<u>173</u>
4 1/2 miles <u>east</u> of <u>MP</u> (distance) (direction) (nearest town)	<u>rock</u>	<u>173</u>	<u>215</u>
WELL PURPOSE: <u>home</u> (home, irrigation, municipal, industrial)			
WELL COMPLETION DATA:			
(1) diameter (inches) <u>2</u>			
(2) total depth (feet) <u><del>215</del> 215</u>			
(3) static water level (feet) <u>24</u> <sup>(below)</sup> above top of ground.			
(4) casing <u>galv</u> , <u>210</u> , (material) (depth)			
(size) if telescope see back.			
(5) screen <u>5'</u> , <u>210</u> (length) (depth to top)			
<u>2"</u> , <u>Stamless</u> (size) (material)			
(6) pump <u>1/2</u> , <u>7</u> (HP) (yield gpm)			
<u>elec</u> (type power)			
(7) electric log <u>no</u> (yes or no)			
(organization running log)			
(8) how well bottom plugged <u>BP Valves</u>			
DRILLERS REMARKS:			


**CODED**

OCT 14 1970

MISS. BD. OF  
 WATER COM.

If well telescopes please sketch and show depths.

GROUND LEVEL

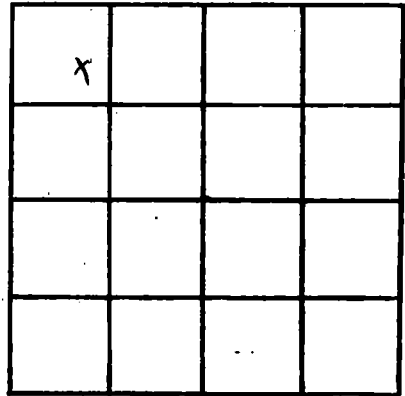

SECTION \_\_\_\_\_

Please indicate well location X.

ADDITIONAL INFORMATION

If more than one screen, show locations of each on sketch.