

Jackson
 Q 337
 4-28-70

MISSISSIPPI
 BOARD OF WATER COMMISSIONERS
 416 North State Street
 Jackson, Mississippi 39201

CODED

WATER WELL DRILLERS LOG

April 28, 1970 *Colville Water Supply* Jackson
 date well completed firm name county well located

LANDOWNER: <i>Sezon Rogers</i>	description of formations encountered	from	to
<i>Mon Point, Miss</i> (mailing address)	<i>Clay red yellow sandy clay soft blue clay light blue clay and sand</i>	<i>0 10 20 40</i>	<i>10 20 40 60</i>
WELL LOCATION: sec. <i>30</i> T <i>7</i> N R. <i>5</i> 006 <i>City limits of Mon Point</i> (distance) miles (direction) of (nearest town) <i>Corner of Bay Ave and Stanton St.</i>			
WELL PURPOSE: <i>irrigation</i> (home, irrigation, municipal, industrial)			
WELL COMPLETION DATA: (1) diameter (inches) <i>2</i> (2) total depth (feet) <i>93</i> (3) static water level (feet) <i>16</i> ^{below} _{above} top of ground. (4) casing <i>plastic 89</i> (material) (depth) (size) if telescope see back. (5) screen <i>4</i> <i>89</i> (length) (depth to top) <i>2</i> <i>plastic</i> (size) (material) (6) pump _____ (HP) _____ (yield gpm) (type power) (7) electric log <i>no</i> (organization running log) (8) how well bottom plugged <i>By Well</i>			


MAY 14 1970

MISS. BD. OF
 WATER COMM

DRILLERS REMARKS: *pump installed by owner*

If well telescopes please sketch and show depths.

GROUND LEVEL

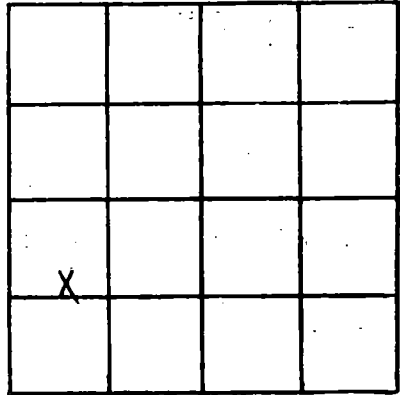

SECTION 30

Please indicate well location X.

ADDITIONAL INFORMATION

If more than one screen, show locations of each on sketch.