

CODED

JACKSON
Q339
11-5-69

MISSISSIPPI
BOARD OF WATER COMMISSIONERS
416 North State Street
Jackson, Mississippi 39201

WATER WELL DRILLERS LOG

nov 5 1969 L.S. Herland Water Wells, Jackson
date well completed firm name county well located

LANDOWNER: D.J. Pharr
Rt 1 Box 347 S
Pascagoula, Miss
(mailing address)

| description of formations encountered | from | to |
|---------------------------------------|------|----|
| | | |

WELL LOCATION:
sec. 36 T. 7 N. R. 5 E
7 miles east of Pascagoula
(distance) (direction) (nearest town)

WELL PURPOSE:
(home, irrigation, municipal, industrial)

WELL COMPLETION DATA:

- (1) diameter (inches) 2"
- (2) total depth (feet) 252
- (3) static water level (feet) _____ below
top of ground. above
- (4) casing steel, 242,
(material) (depth)
2 If telescope see back.
(size)
- (5) screen 10 ft., 242
(length) (depth to top)
2", stainless steel
(size) (material)
- (6) pump _____ (HP) _____ (yield gpm)
Customer has own
(type power) pump
- (7) electric log _____
(yes or no)

(organization running log)
- (8) how well bottom plugged mesh valve

DRILLERS REMARKS:


30 ft. water
bearing sand

NOV 17 1969

MISS. BD. OF
WATER COM.

If well telescopes please sketch and show depths.

GROUND LEVEL

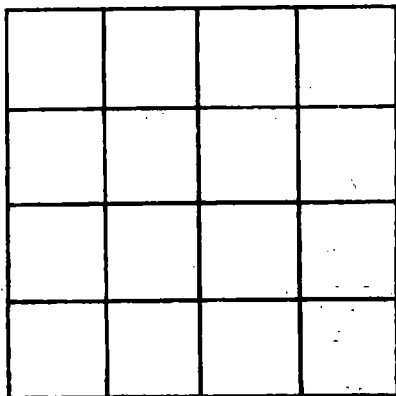

SECTION _____

Please indicate well location X.

ADDITIONAL INFORMATION

A series of horizontal lines providing space for additional information or notes.

If more than one screen, show locations of each on sketch.