

FEB 16 1971

JACKSON  
Q 340  
1-7-71

MISSISSIPPI  
BOARD OF WATER COMMISSIONERS MISS. BD. OF  
416 North State Street WATER COMM.  
Jackson, Mississippi 39201

WATER WELL DRILLERS LOG

**CODED**

Jan 7 1971 date well completed  
Cobville Water Supply firm name  
Jackson county well located

LANDOWNER: Harden  
Construction  
Pascagoula Miss  
(mailing address)  
WELL LOCATION:  
Irregular sec 7  
sec. 7 N R 5 E  
Pascagoula City Limits  
miles of (nearest town)

description of formations encountered	from	to
<u>sand</u>	<u>0</u>	<u>15</u>
<u>clay</u>	<u>15</u>	<u>115</u>
<u>sand</u>	<u>115</u>	<u>216</u>
<u>clay</u>	<u>216</u>	<u>237</u>
<u>sand</u>	<u>237</u>	<u>280</u>

WELL PURPOSE: office  
(home, irrigation, municipal, industrial)


WELL COMPLETION DATA:  
(1) diameter (inches) 2  
(2) total depth (feet) 280  
(3) static water level (feet) 34 (below/above top of ground)  
(4) casing galv., 275,  
(material) (depth)  
(size) if telescope see back.  
(5) screen 5, 275  
(length) (depth to top)  
2, stainless  
(size) (material)  
(6) pump 1, 80  
(HP) (yield gpm)  
elec  
(type power)  
(7) electric log no  
(yes or no)  
(organization running log)  
(8) how well bottom plugged BP Velop

**CODED**

DRILLERS REMARKS:

If well telescopes please sketch and show depths.

GROUND LEVEL

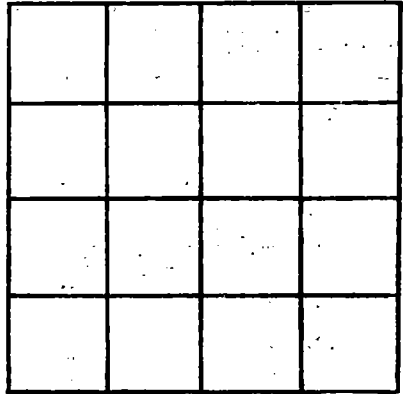

*irregular section*  
SECTION 7

Please indicate well location X.

ADDITIONAL INFORMATION

If more than one screen,  
show locations of each on sketch.