

JACKSON
PQ 343
10-29-62

17
WATER WELL DRILLERS LOG

506 3781 4346

CODED

Date: Oct 29, 1962, Driller: George Colville County Jackson
(Name)

(1) Owner of Land: C. J. Walker
(Name)

Paragould, Miss
(Address)

(2) Location: 1/4, 1/4, Sec. 31 T7R5

 miles , of
(distance) (direction) (Nearest Town)

(3) Topography: Flat
(Hilly) (Flat) (Level)

(4) Purpose of Well: Domestic
(Domestic Irrigation
Municipal, Industrial, Other)

Description & Color of Materials Sand, Clay, Red Clay, Shell, etc.	Thick- ness Feet	Depth Feet
<u>0-21 sand</u>		
<u>21-58 clay</u>		
<u>58-63 sand</u>		
<u>63-95 clay</u>		
<u>95-100 sand</u>		
<u>100-105 clay</u>		
<u>105-138 gravel</u>		
<u>138-147 clay</u>		
<u>147-164 sand</u>		
<u>164-168 clay</u>		
<u>168-200 sand</u>		
<u>200-273 clay</u>		
<u>273-285 sand</u>		

Information upon completion of well:

(1) Diameter 2" inches.

(2) Total Depth 285 feet.

(3) Water Level 60'8" feet below top of ground.

(4) Cased to , Size

(5) Screen: Size 2", Length 10'

(6) Were any formations sealed against pollution?


 yes, X no.

If YES depth of formation

Why

Drillers Remarks:

CODED

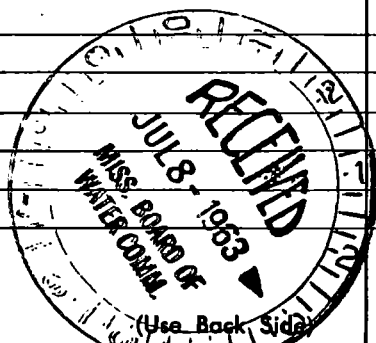

Well No.
187

